

ADDENDUM NO.: 2

DATE OF ADDENDUM: December 8, 2015

Energy Upgrades
Greater Bridgeport Community Mental Health Center
Bridgeport, CT
BI – MH – 111

Original Bid Due Date / Time:

December 16, 2015

1:00 pm

Previous Addendums

Addendum dated November 18, 2015

TO: Prospective Bid Proposers:

This Addendum forms part of the "Contract Documents" and modifies or clarifies the original "Contract Documents" for this Project dated May 27, 2015. Prospective Bid Proposers shall acknowledge receipt of the total number the Addenda issued for this Project on the space provided on Section 00 41 00 Bid Proposal Form. Failure to do may subject Bid Proposers to disqualification.

The following clarifications are applicable to drawings and specifications for the project referenced above.

Item 1

Question: Will you accept Siemens's Talon and Gamma Brand's BacNet , KNX open protocol control system as alternate to the 3 manufacturers listed?

Response: Not one of the 3 manufacturers listed, but a good manufacturer, nevertheless. Suggest Siemens process an "Equals or Substitution Product Request" on DAS/DCS Form 7001 attached.

Item 2

Question: Can you provide the name of the sprinkler service company who maintains the system at 1635 Central Avenue?

Response: Break fire is the name of the sprinkler company. Their phone number is 203-378-9834.

Item 3

Question: Can you provide the name of the roofing company who maintains the roof at 1635 Central Avenue?

Response: The roof is no longer under warranty, however Eagle Roofing has been doing most of the repairs recently.

Item 4

Question: Can you provide As -Built drawings of the existing Control system, both Electronic and pneumatic?

Response: A copy of the original DDC installation dated 1993 is attached. These drawings strongly suggest that this is a single pressure system and that these pneumatics are not used for timing.

Item 5

Clarification: The SOO for the pneumatic system indicates 2 pressure settings to operate occupied unoccupied. During the walk thru I did not see the current installation could support this.

Response: See Item 4 response.

Item 6

Question: Can you confirm space for staging area , including ConnEx box and space to receive deliveries will be made available, and how far from building if not in parking lot?

Response: There is room on the property for a 20 foot storage container near the loading dock.

ADDENDUM NO.: 2

DATE OF ADDENDUM: December 8, 2015

Item 7

Question: Will it be acceptable to use Sch 40 black steel threaded pipe and BCI threaded fittings for piping 1 1/2" and below?

Response: Schedule 40 carbon steel is acceptable in all sizes. Joints can be threaded for sizes 1 1/2" and below.

All questions must be in writing and must be forwarded to the consulting Architect/Engineer (Jennifer Thurber @ (Fuss & O'Neill)) with copies sent to the DCS Project Manager (Wayne E. Thorpe @ email: wayne.thorpe@ct.gov).

End of Addendum 2



Mellanee Walton, Associate Fiscal Administrative Officer
Department of Administrative Services
On Behalf of the Division of Construction Services

Request Phase Pre-Bid Post Bid (See Article 15 Materials: Standards, General Conditions)

(If Pre-bid only) Current Bid Due Date: _____ Request No.: _____ Dated: _____

To: State of Connecticut DCS Project No.: _____
 Department of Administrative Services Project Name / Location: _____
 Division of Construction Services

References:	Specification(s): _____	Section(s): _____	Paragraph(s): _____
	Drawing(s): _____	Drawing(s) No(s): _____	Detail(s) No(s): _____
Contractually Specified Product: _____			
Contractor Proposed Product: _____			
Proposed Product is : Equal: <input type="checkbox"/> Substitute: <input type="checkbox"/> Model No.: _____			
<i>See attached data for both specified and proposed products as required by Article 15 General Conditions.</i>			
Data attached:	Drawings: <input type="checkbox"/>	Product Data: <input type="checkbox"/>	Reports: <input type="checkbox"/> Samples: <input type="checkbox"/>
	Tests: <input type="checkbox"/>	Other: _____	
Reason(s) for not providing the Specified Product: _____			
Similar Installation:			
Project:		Architect:	
Address:		Owner:	
		Date Installed:	

Will proposed substitution impact other parts of the Work?	No <input type="checkbox"/>	Yes <input type="checkbox"/>	<i>If yes attach explanation.</i>
Will proposed substitution increase Contract Time?	No <input type="checkbox"/>	Yes <input type="checkbox"/>	<i>by number of Days</i> _____
Actual Dollar Savings to the State of Connecticut if substitution is accepted: \$ _____			
The Undersigned Certifies that the proposed Request for an Equal or Substitute Product conforms to all of the requirements of Division 01 General Requirements, Section 01 25 00 Substitution Procedures.			
Request Submitted By General Contractor / CMR: _____ <i>(Firm's Typed Name)</i>			
By: _____	_____	_____	_____
<i>(Typed Name)</i>	<i>(Title)</i>	<i>(Signature)</i>	<i>(Date)</i>
CONTRACTOR / CMR Send copies to DCS PM: <input type="checkbox"/> CA: <input type="checkbox"/>			


Consultant's Review – This Substitution Request is:		Request Received on (Date): _____
<input type="checkbox"/> Approved:	<i>(Submittals in accordance with Div. 01 General Requirements, Section 01 33 00 Submittal Procedures.)</i>	
<input type="checkbox"/> Approved as Noted:	<i>(Submittals in accordance with Div. 01 General Requirements, Section 01 33 00 Submittal Procedures.)</i>	
<input type="checkbox"/> Rejected:	Use Specified Materials.	
<input type="checkbox"/> Rejected:	Request Not Received Within Specified Time Period - Use Specified Materials.	
Reviewed Issued By: _____	_____	_____
<i>(Typed Name)</i>	<i>(Signature)</i>	<i>(Date)</i>
CONSULTANT Send copies to: DCS PM: <input type="checkbox"/> CA: <input type="checkbox"/> Chief Architect <input type="checkbox"/> Chief Engineer <input type="checkbox"/>		

If Approved: As noted by Consultant,
DCS Chief Architect: _____
(Signature) *(Date)*

Copies: Project File Red R2

Alpen

John

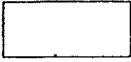


BRIDGEPORT MENTAL HEALTH CENTER
BRIDGEPORT, CONNECTICUT

TEMPERATURE CONTROL
OPERATION AND MAINTENANCE MANUAL
AS BUILT DRAWINGS

PREPARED BY:
R.C. MARRA SYSTEMS, INC.
WALLINGFORD, CONNECTICUT

1993

DRAWING	DESCRIPTION
GROUND FLOOR PANEL	
1	RISER DIAGRAM
2	AH-1 FLOW DIAGRAM
3	AC-1 FLOW DIAGRAM
4	AC-2 FLOW DIAGRAM
5	AH-1, AC-1 AND AC-2 PANEL DETAIL (SAFETY SHUTDOWN)
6	AH-1 PANEL DETAIL (HVAC CONTROL)
7	AC-1 PANEL DETAIL "
8	AC-2 PANEL DETAIL "
9	AH-1, AC-1 AND AC-2 PANEL DETAIL (CONTROL MODULES)
FIRST FLOOR PANEL	
10	AC-3 FLOW DIAGRAM
11	AC-6 PANEL DETAIL (SAFETY SHUTDOWN)
12	AC-5 PANEL DETAIL "
13	AC-4 AND AC-3 PANEL DETAIL (SAFETY SHUTDOWN)
14	AC-3 PANEL DETAIL (HVAC CONTROL)
15	AC-3 PANEL DETAIL (CONTROL MODULE)
16	HEAT PUMP CONTROL DETAIL (CONTROL MODULE)
EIGHTH FLOOR PANEL	
17	AC-10 AND AC-4 FLOW DIAGRAM
18	AC-10 AND AC-9 PANEL DETAIL (SAFETY SHUTDOWN)
19	AC-8 AND AC-7 PANEL DETAIL "
20	AC-10 PANEL DETAIL (HVAC CONTROL)
21	AC-10 AND AC-4 PANEL DETAIL (CONTROL MODULE)
22	HEAT PUMP CONTROL DETAIL (CONTROL MODULE)
TYPICAL FLOOR PANELS	
23	AC-5, 6, 7, 8 AND AC-9 FLOW DIAGRAM
24	TYPICAL PANEL DETAIL (SAFETY AND HVAC CONTROL)
25	TYPICAL PANEL DETAIL (CONTROL MODULE)
26	REHEAT CONTROL DETAIL

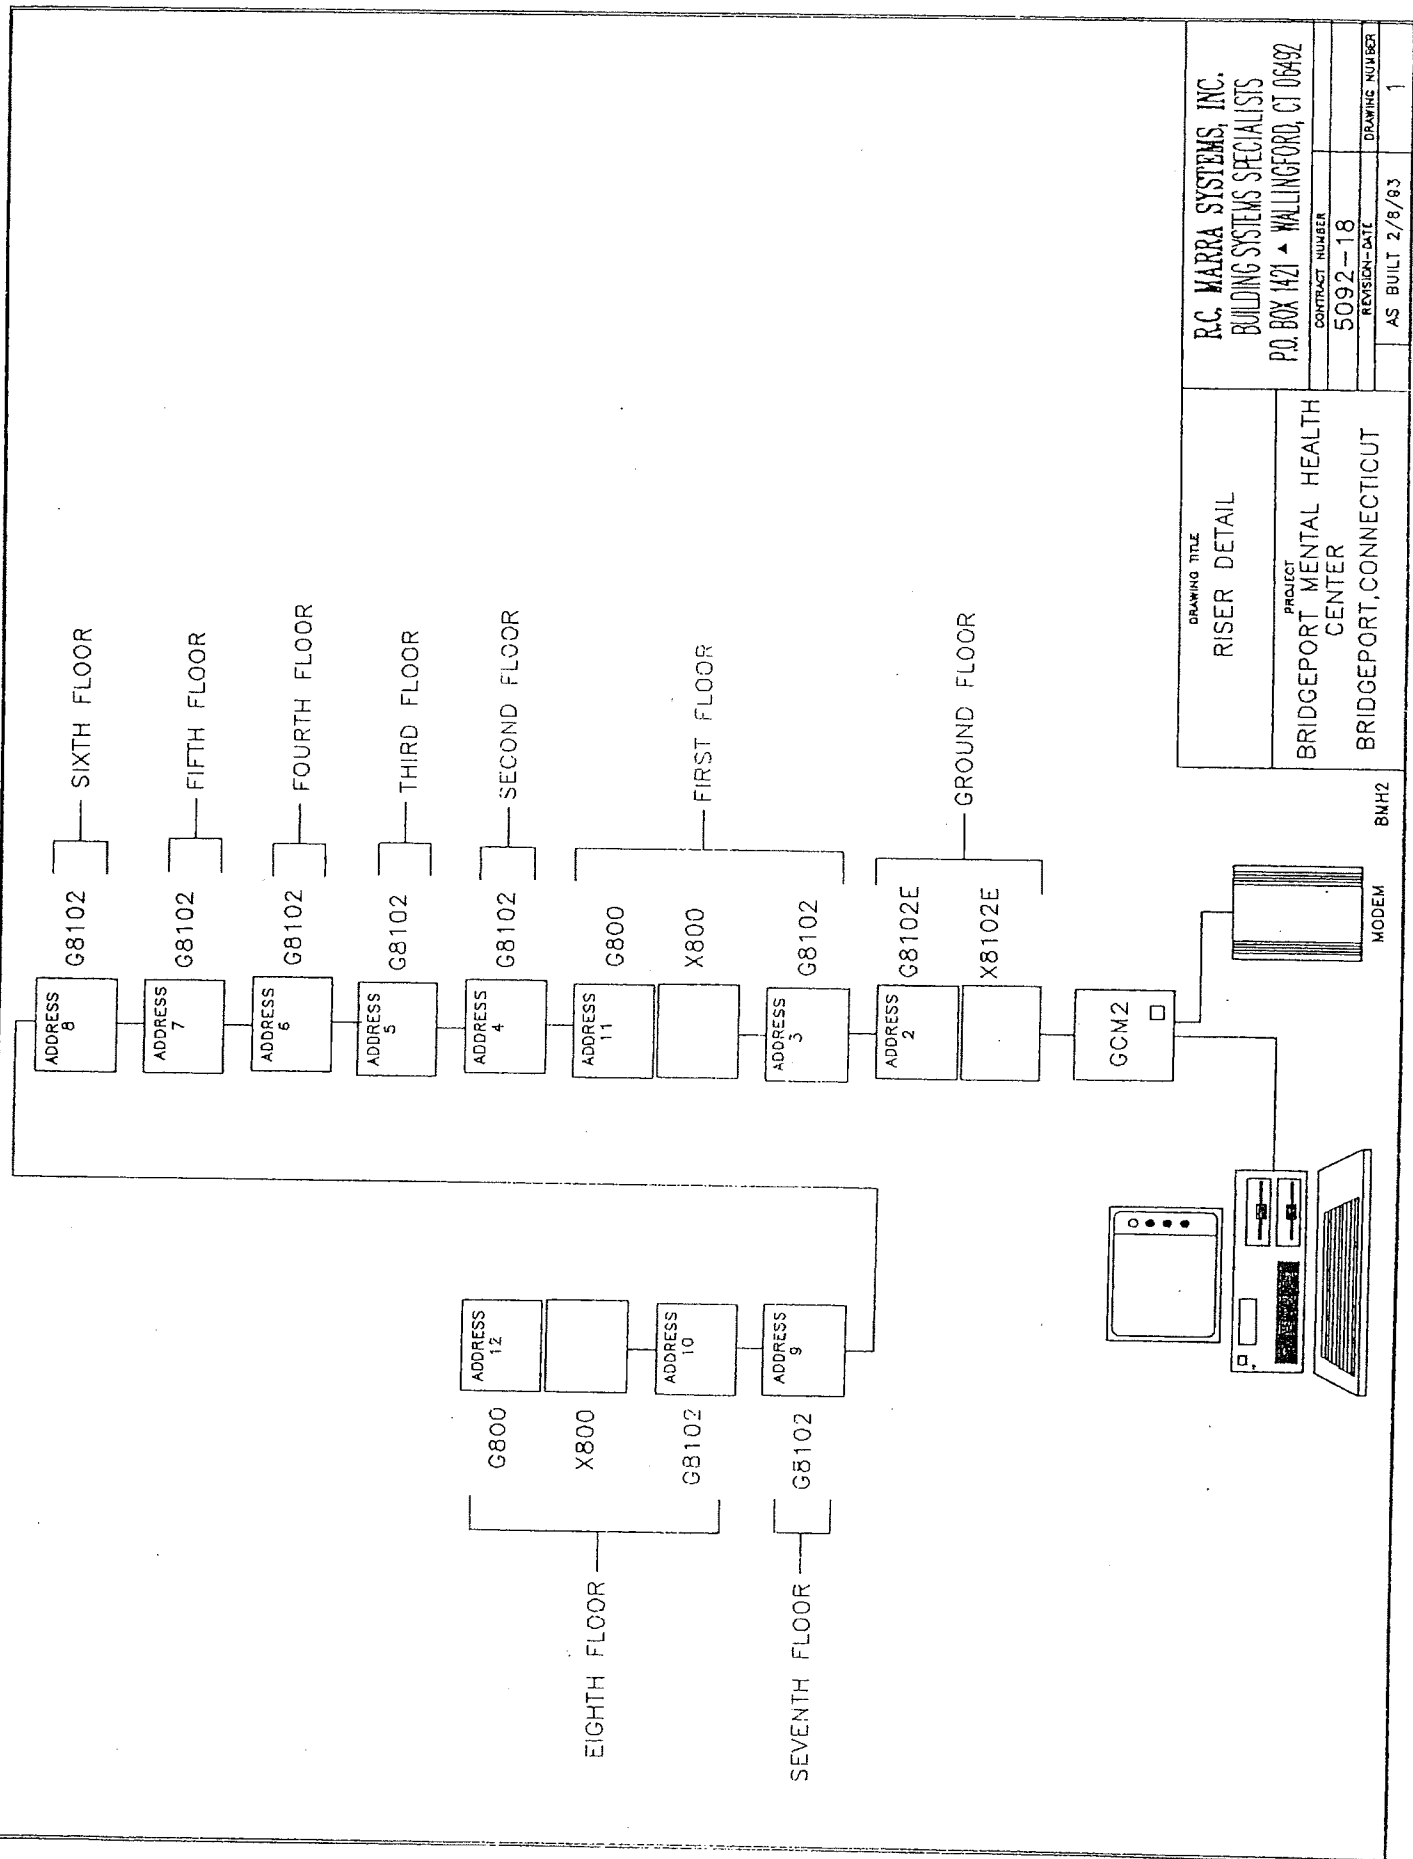


DRAWING TITLE
RISER DETAIL

PROJECT
BRIDGEPORT MENTAL HEALTH CENTER
BRIDGEPORT, CONNECTICUT

R.C. MARRA SYSTEMS, INC.
BUILDING SYSTEMS SPECIALISTS
P.O. BOX 1421 • WALLINGFORD, CT 06492

CONTRACT NUMBER	5092-18
REVISION-DATE	AS BUILT 2/8/83
DRAWING NUMBER	1


BMH2

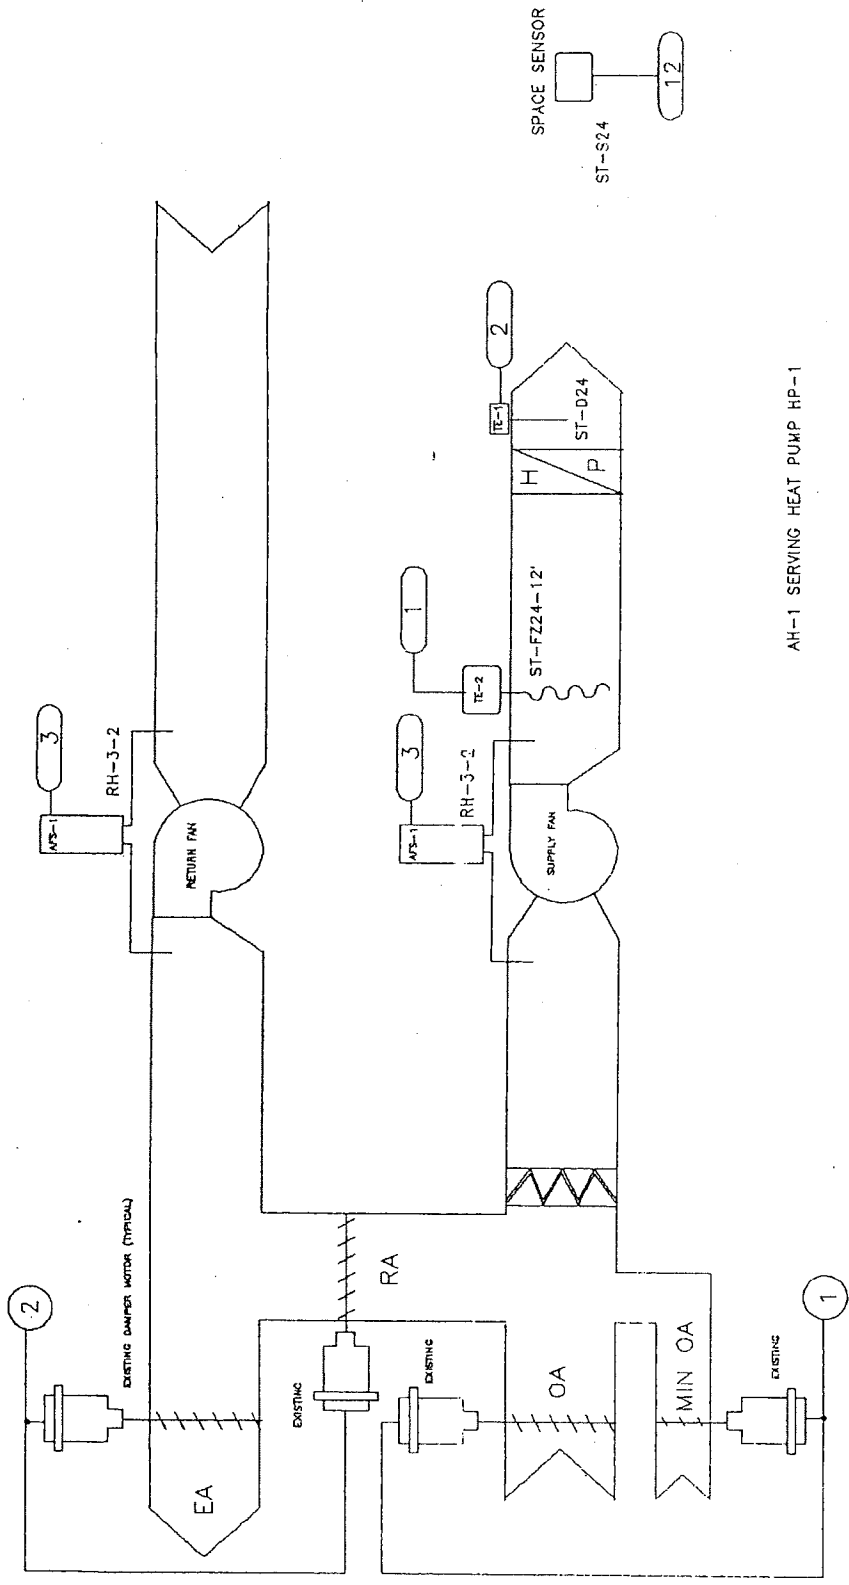

AH-1 SERVING HEAT PUMP HP-1

DRAWING TITLE		R.C. HARRA SYSTEMS, INC. BUILDING SYSTEMS SPECIALISTS P.O. BOX 1421 • WALLINGFORD, CT 06492	
AH-1 FLOW DETAIL		CONTRACT NUMBER	5092-18
PROJECT		REVISION-DATE	AS BUILT 2/8/93
BRIDGEPORT MENTAL HEALTH CENTER		DRAWING NUMBER	
BRIDGEPORT, CONNECTICUT		2	


BMH15

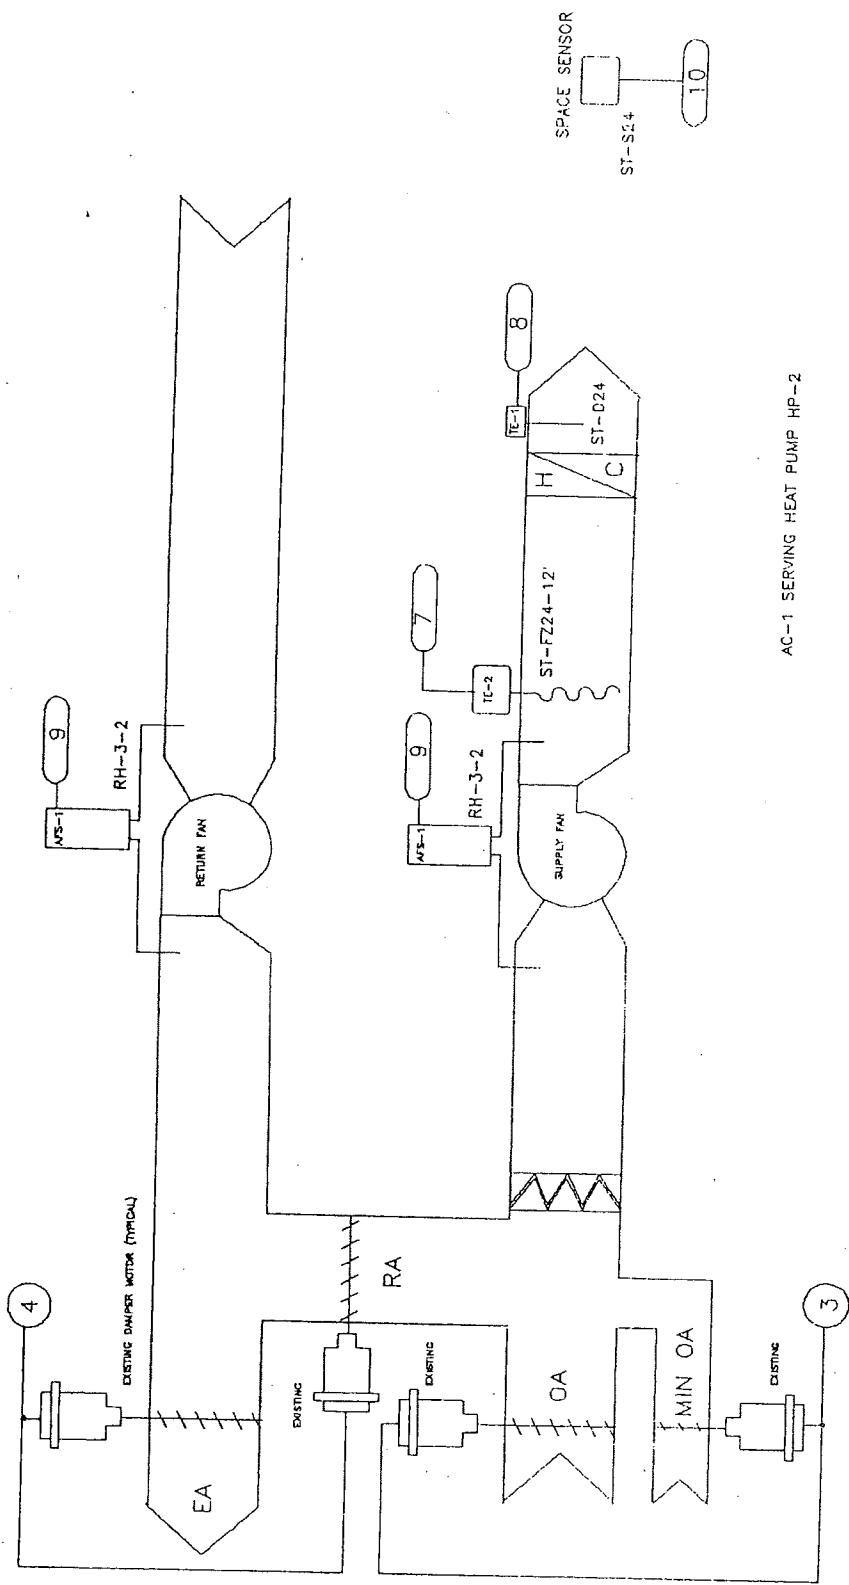

AC-1 SERVING HEAT PUMP HP-2

DRAWING TITLE		R.C. MARRA SYSTEMS, INC. BUILDING SYSTEMS SPECIALISTS P.O. BOX 1421 • WALLINGFORD, CT 06492	
AC-1 FLOW DETAIL		CONTRACT NUMBER	5092-18
PROJECT		REVISION-DATE	AS BUILT 2/8/93
BRIDGEPORT MENTAL HEALTH CENTER		DRAWING NUMBER	3
BRIDGEPORT, CONNECTICUT			


BMH16

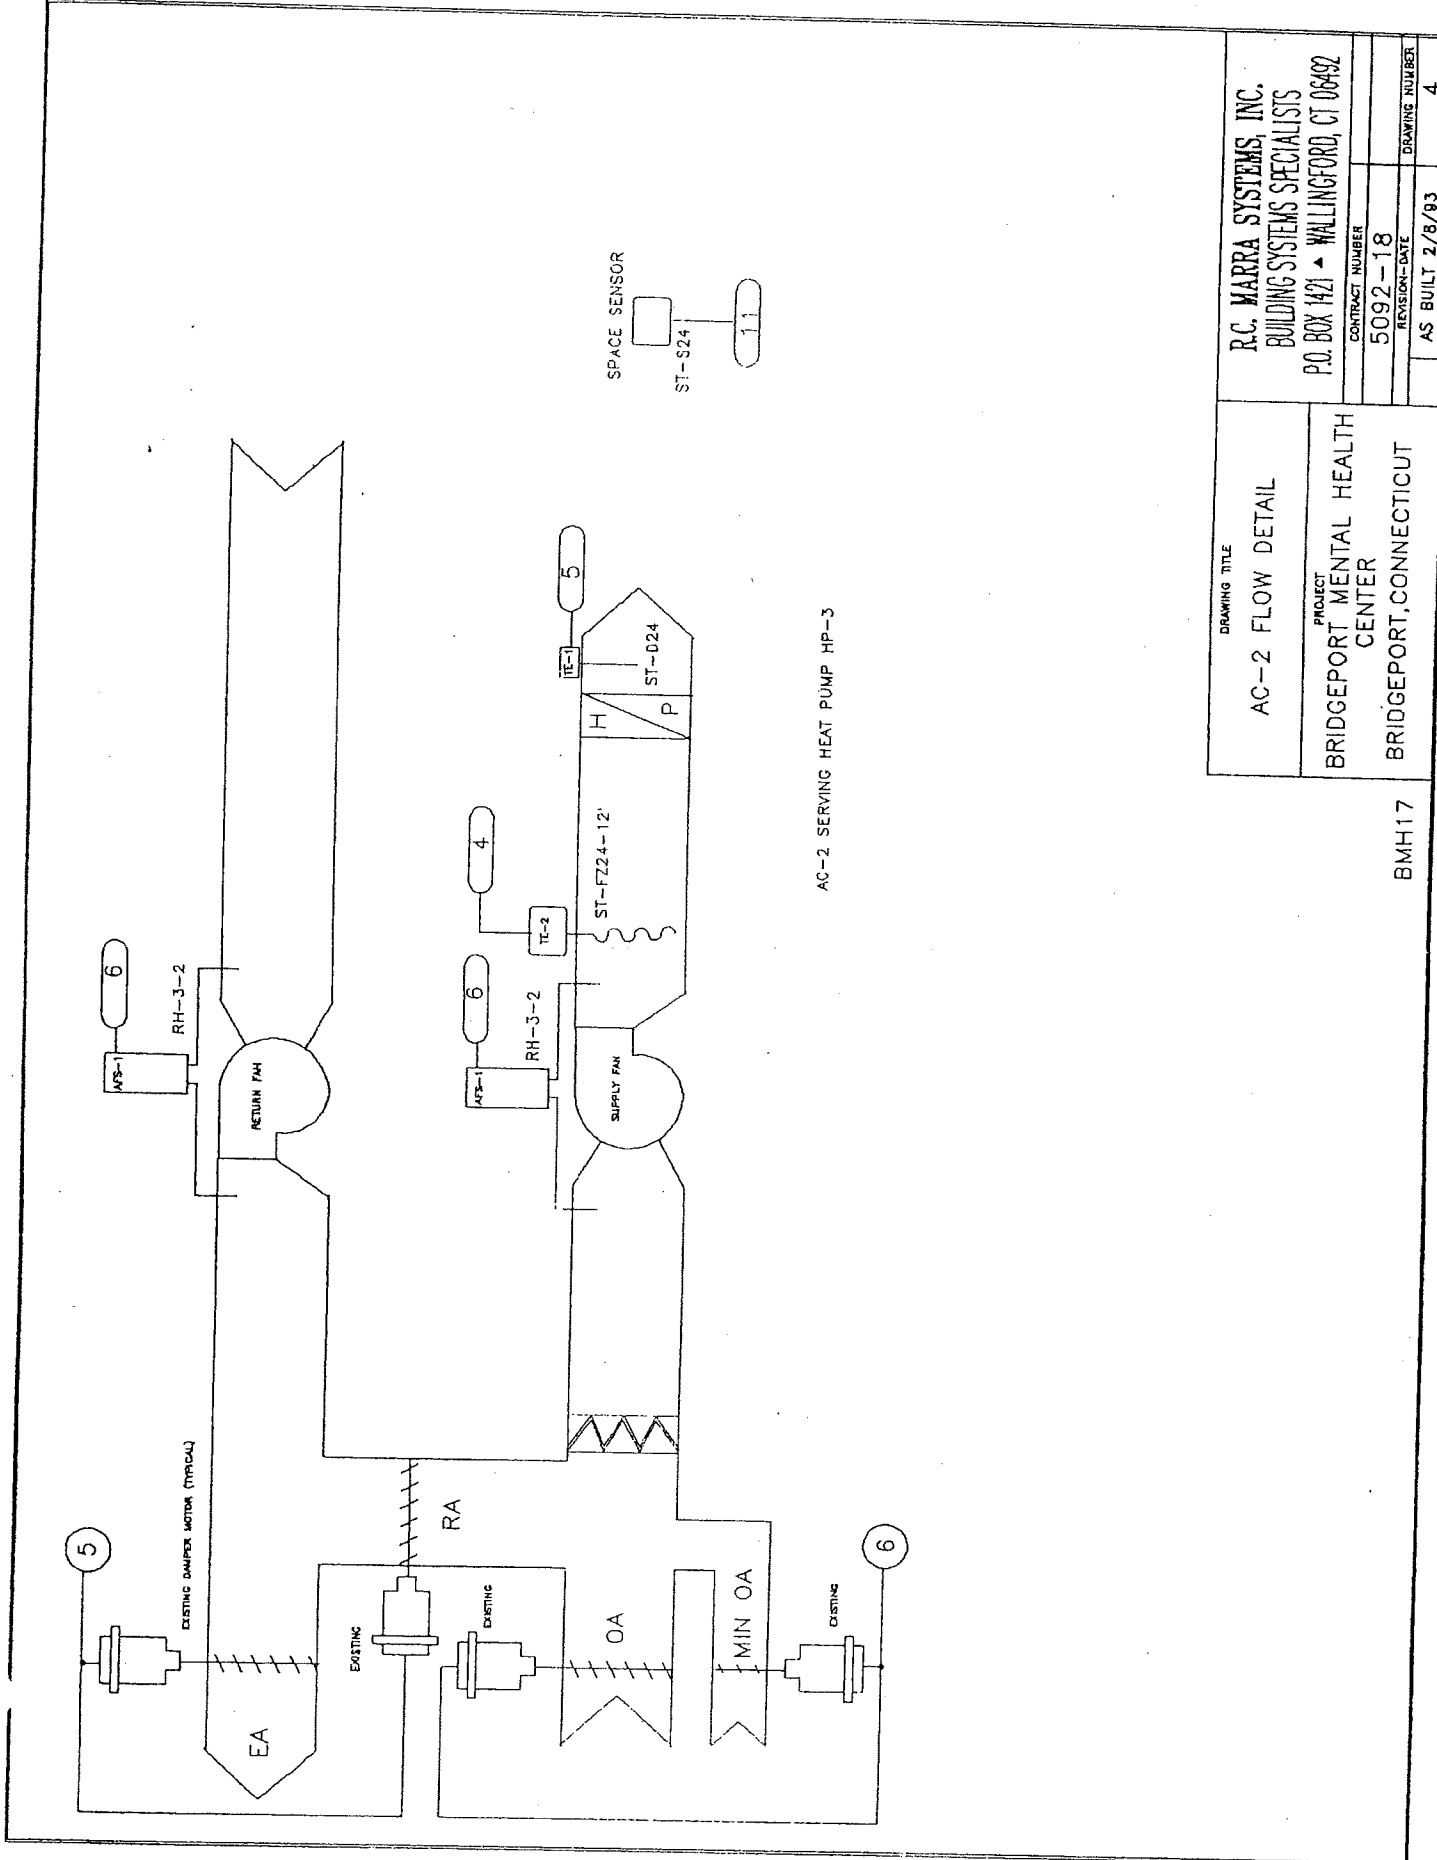

AC-2 SERVING HEAT PUMP HP-3


DRAWING TITLE		R.C. MARRA SYSTEMS, INC. BUILDING SYSTEMS SPECIALISTS P.O. BOX 1421 • WALLINGFORD, CT 06492	
AC-2 FLOW DETAIL		CONTRACT NUMBER	5092-18
PROJECT		REVISION-DATE	AS BUILT 2/8/93
BRIDGEPORT MENTAL HEALTH CENTER		DRAWING NUMBER	
BRIDGEPORT, CONNECTICUT		4	

BMH17

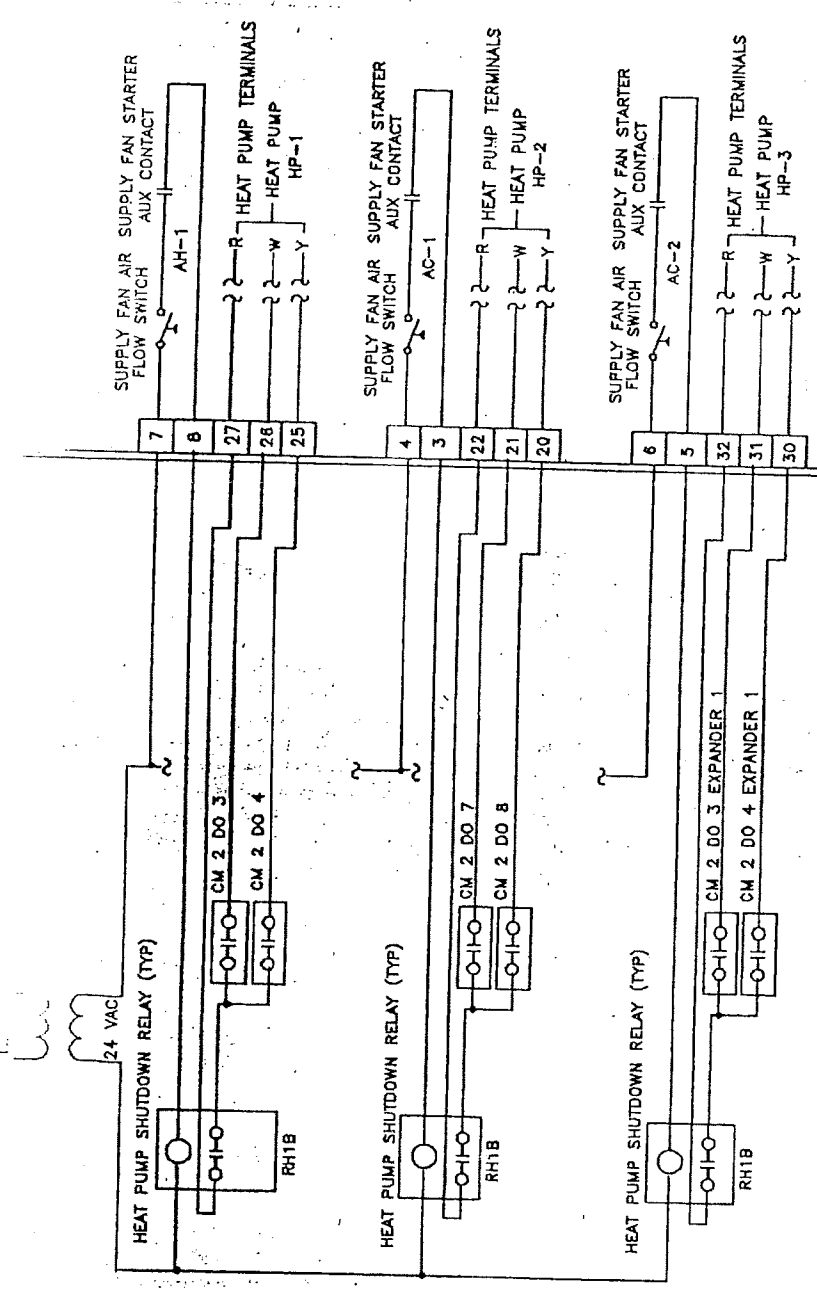

DRAWING TITLE AH-1, AC-1, AC-2 PANEL DETAIL		R.C. MARRA SYSTEMS, INC. BUILDING SYSTEMS SPECIALISTS P.O. BOX 1421 • WALLINGFORD, CT 06492	
PROJECT BRIDGEPORT MENTAL HEALTH CENTER		CONTRACT NUMBER 5092-18	REVISION-DATE AS BUILT 2/8/93
BRIDGEPORT, CONNECTICUT		DRAWING NUMBER 5	

BMH21

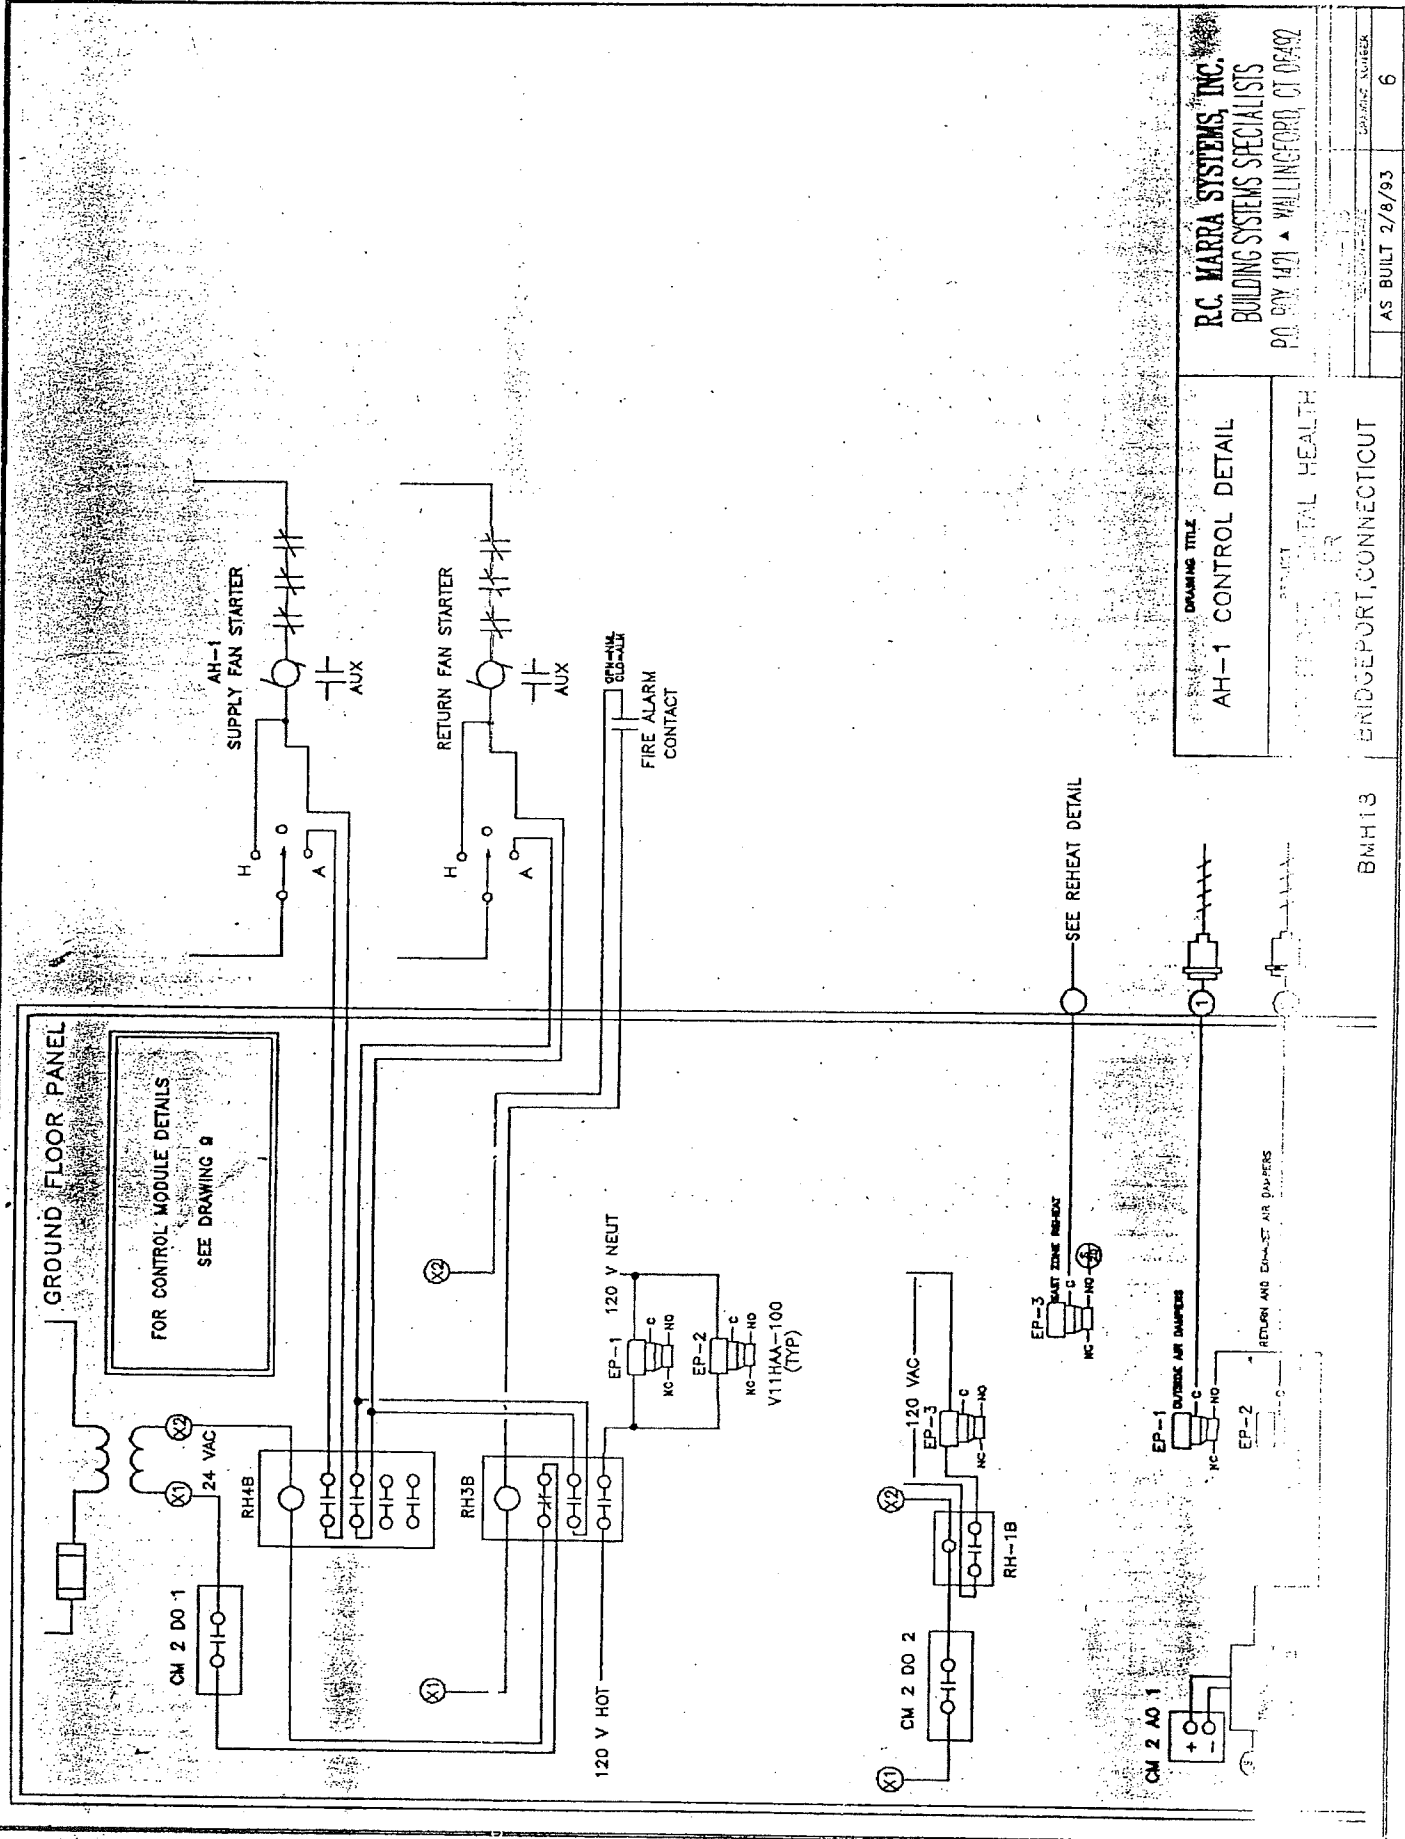

R.C. MARA SYSTEMS, INC.
BUILDING SYSTEMS SPECIALISTS
 PO BOX 1471 • WILLINGFORD, CT 06492


DRAWING TITLE
AH-1 CONTROL DETAIL

PROJECT: **BRIDGEPORT MENTAL HEALTH**
 LOCATION: **BRIDGEPORT, CONNECTICUT**

DATE: **2/8/93**
 DRAWING NUMBER: **6**

BMHT3


GROUND FLOOR PANEL

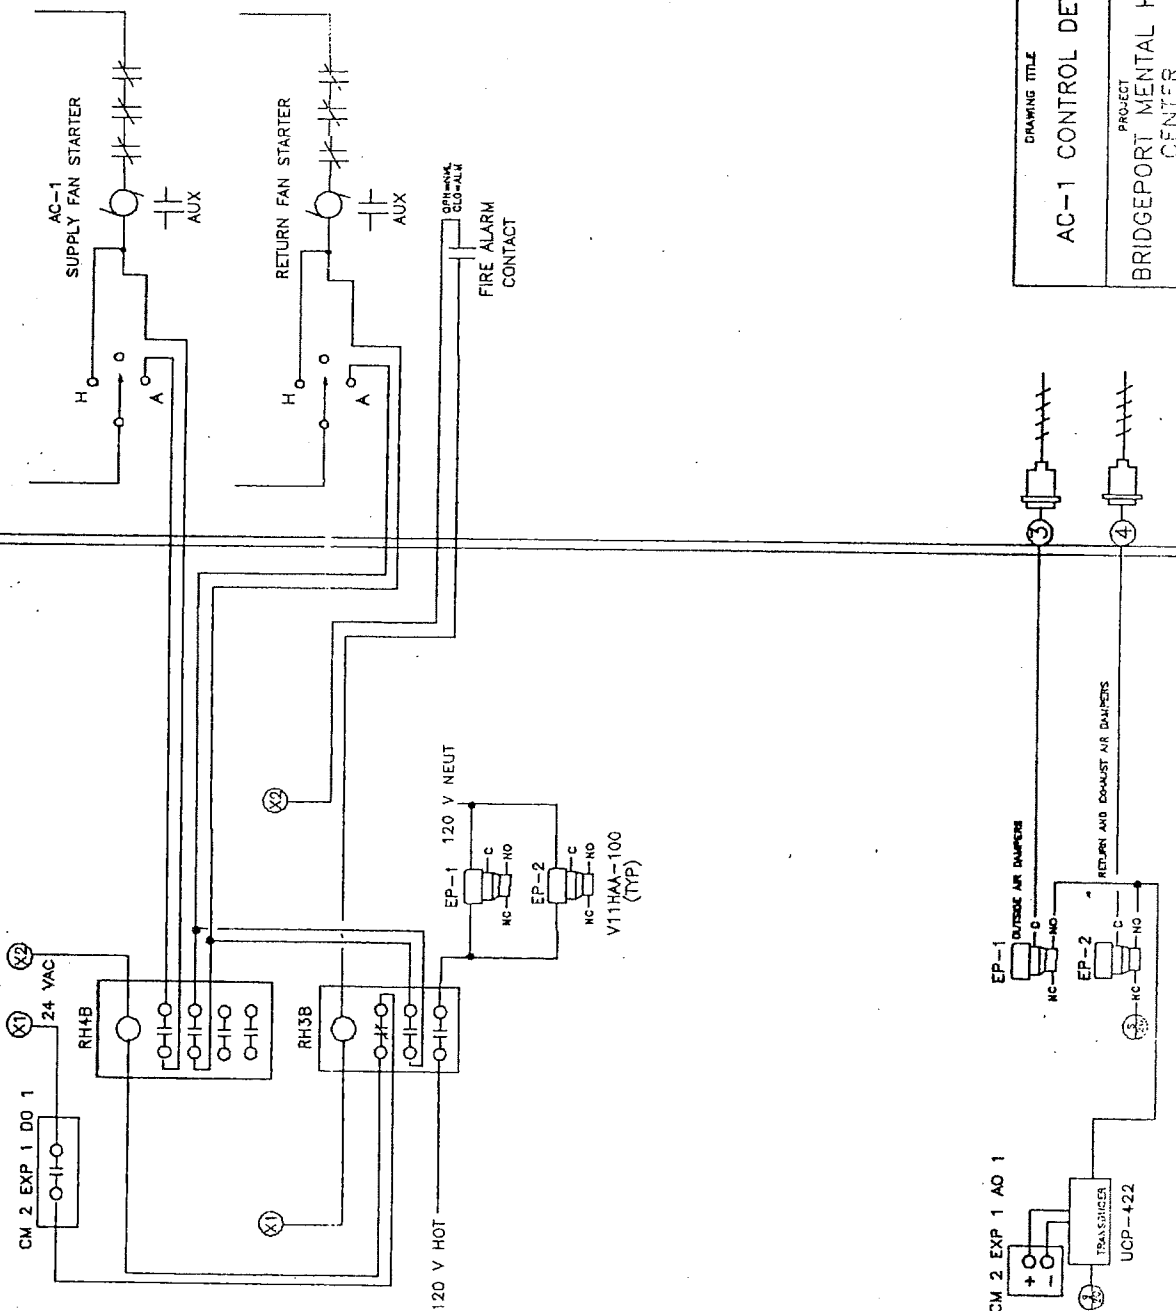

DRAWING TITLE		R.C. MARRA SYSTEMS, INC. BUILDING SYSTEMS SPECIALISTS P.O. BOX 1421 • WALLINGFORD, CT 06492	
PROJECT		CONTRACT NUMBER	5092-1B
BRIDGEPORT MENTAL HEALTH CENTER		REVISION-DATE	AS BUILT 2/8/95
BRIDGEPORT, CONNECTICUT		GRAPHIC NUMBER	7


BMH19

GROUND FLOOR PANEL

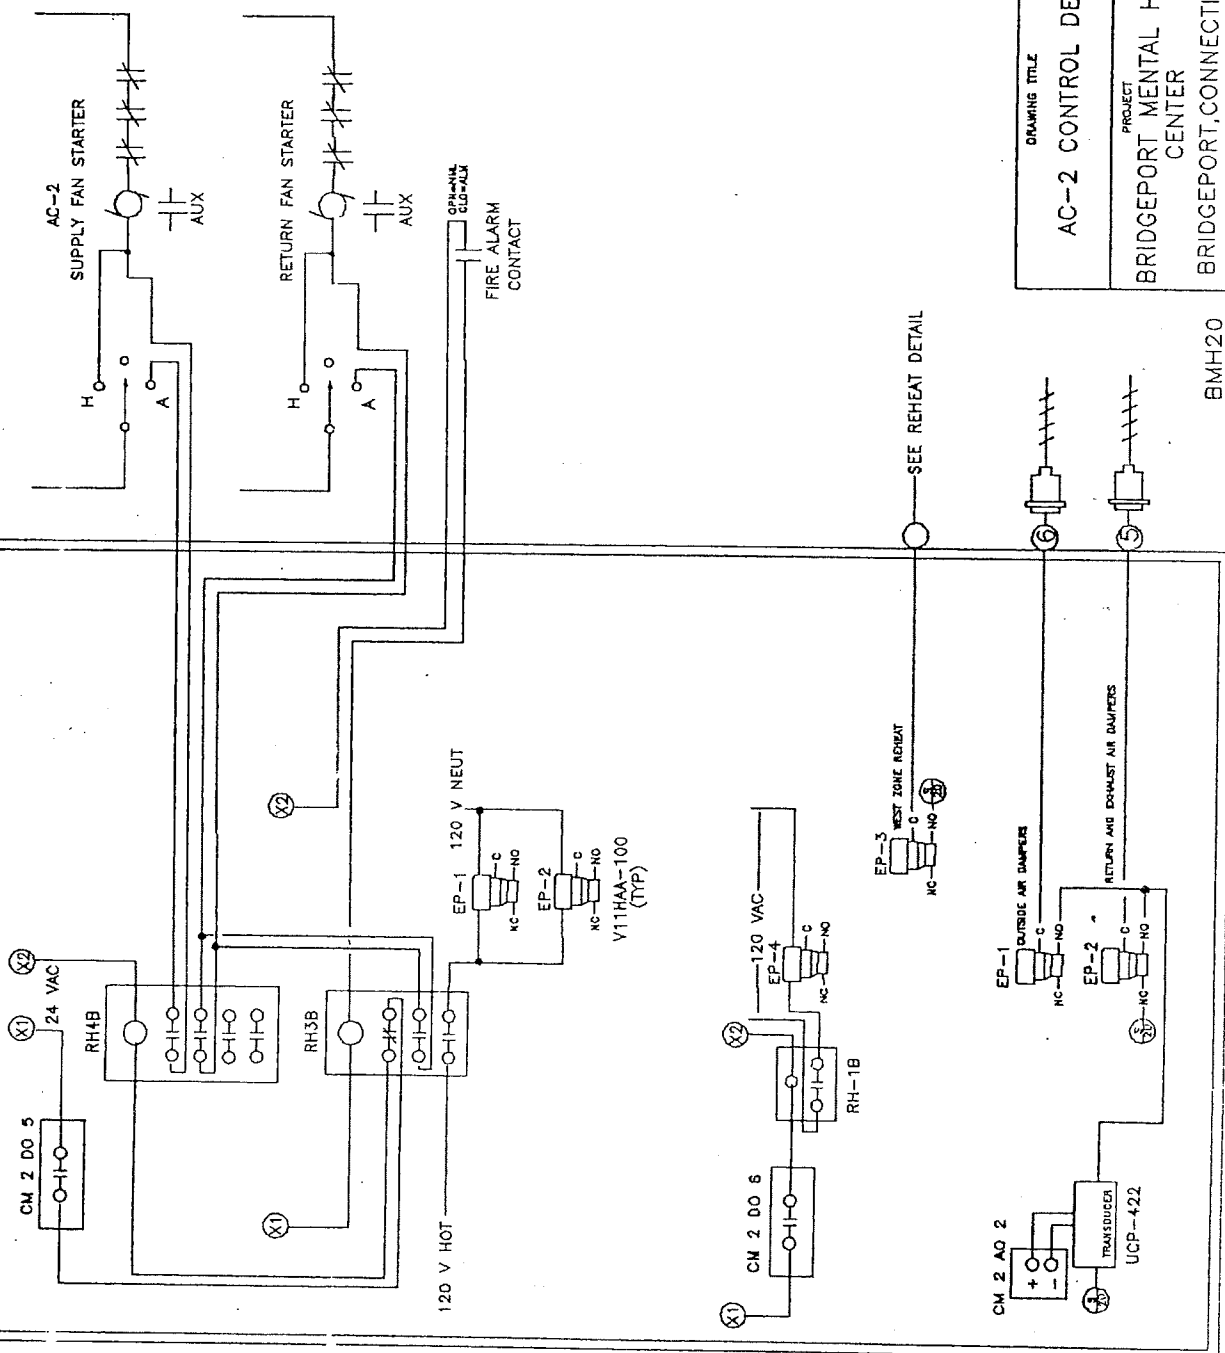

DRAWING TITLE		R.C. MARRA SYSTEMS, INC. BUILDING SYSTEMS SPECIALISTS P.O. BOX 1421 • WALLINGFORD, CT 06492	
PROJECT		CONTRACT NUMBER	5092-18
AC-2 CONTROL DETAIL		REVISION-DATE	AS BUILT 2/8/93
BRIDGEPORT MENTAL HEALTH CENTER		ISSUANCE NUMBER	8
BRIDGEPORT, CONNECTICUT			


BMH20

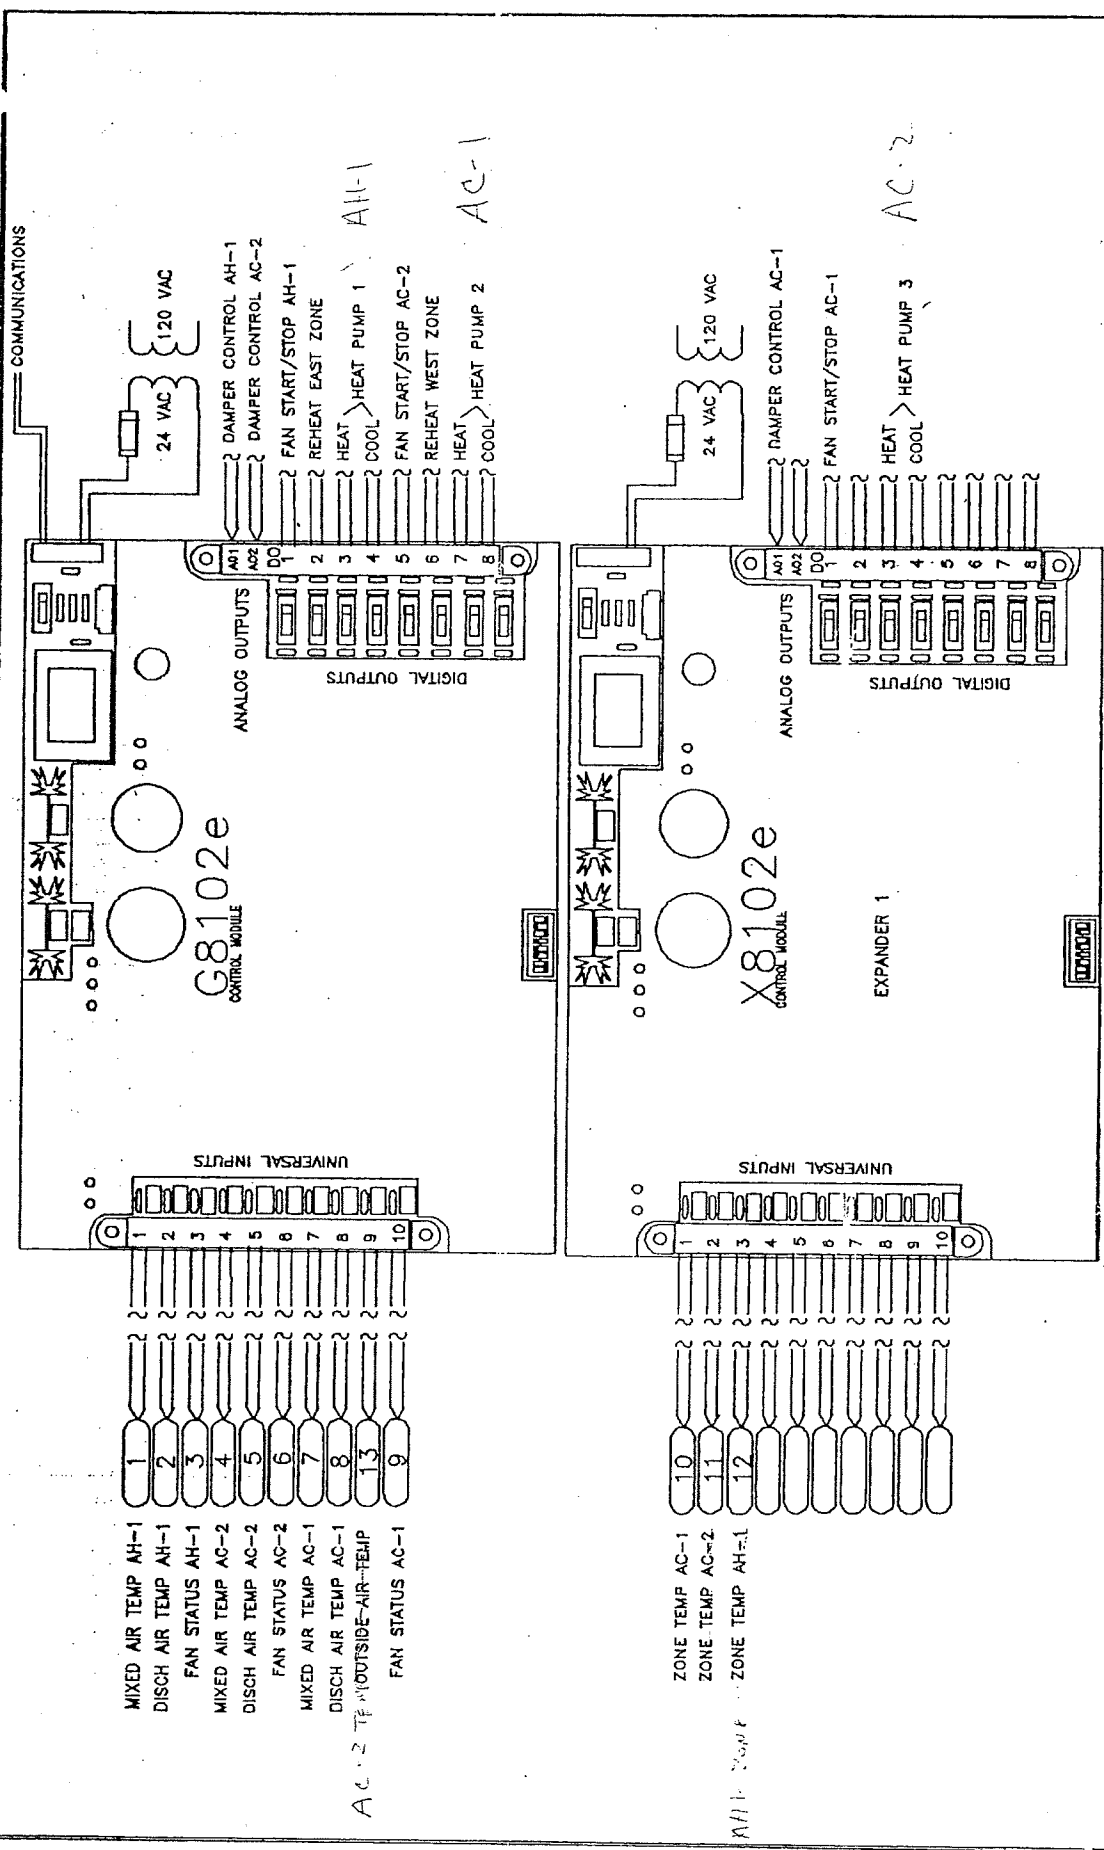


CONTROL MODULE DETAIL FOR AH-1, AC-1, AC-2 CM2

DRAWING TITLE		R.C. MARRA SYSTEMS, INC. BUILDING SYSTEMS SPECIALISTS P.O. BOX 1421 • WALLINGFORD, CT 06492	
CONTROL MODULE 2 DETAIL		CONTRACT NUMBER	5092-18
PROJECT		REVISION-DATE	AS BUILT 3/8/93
BRIDGEPORT MENTAL HEALTH CENTER		DRAWING NUMBER	9
BRIDGEPORT, CONNECTICUT			

BMH22

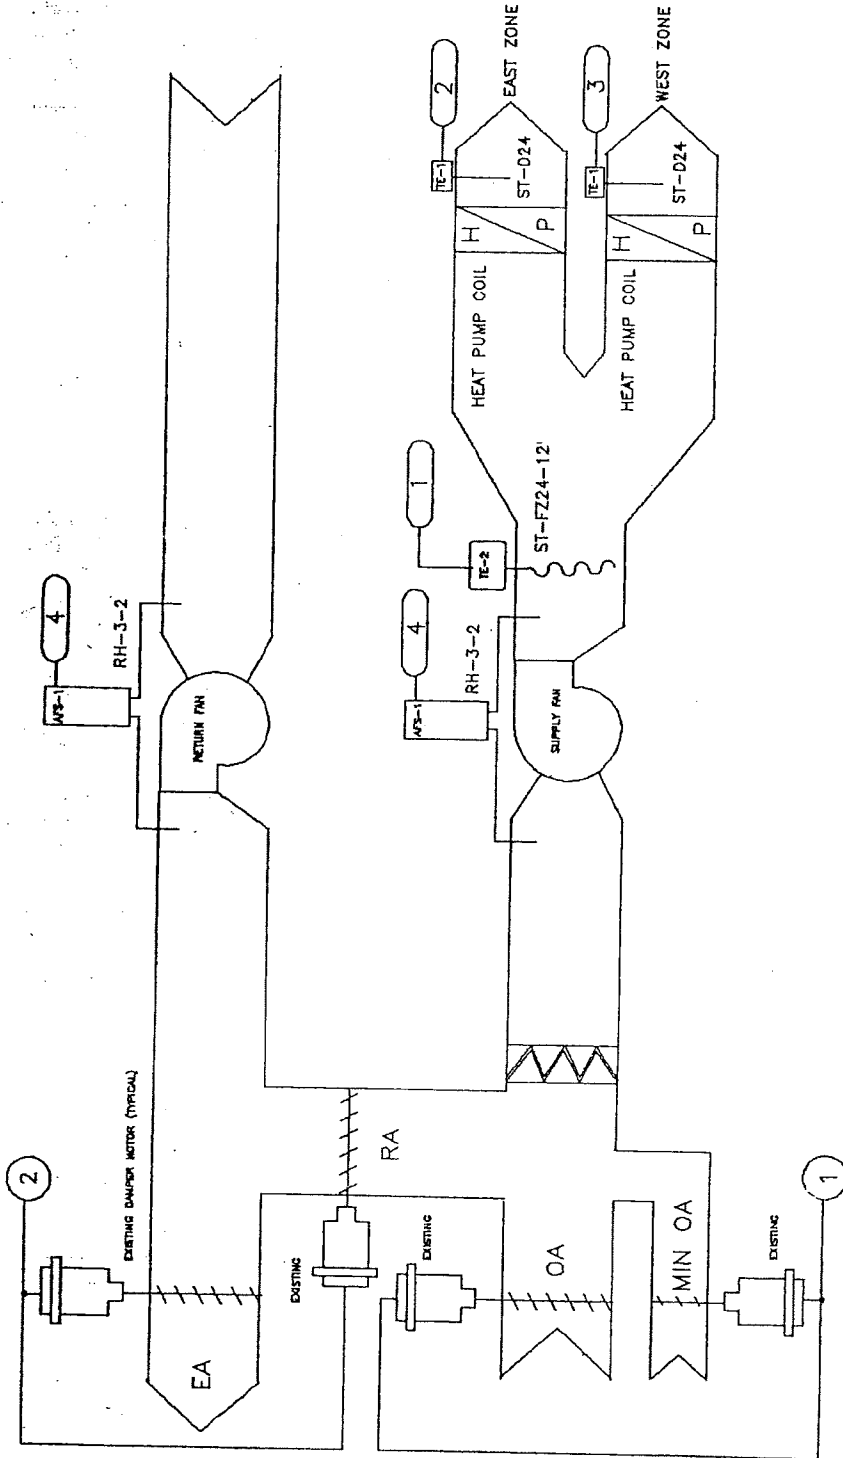


SEE REHEAT DETAIL

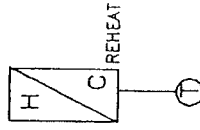

DRAWING TITLE	
AC-3 FLOW DETAIL	
PROJECT	
BRIDGEPORT MENTAL HEALTH CENTER	
BRIDGEPORT, CONNECTICUT	
CONTRACT NUMBER	
5092-18	
REVISION-DATE	
AS BUILT 2/8/83	
DRAWING NUMBER	
10	

BMH24


R.C. WARRA SYSTEMS, INC.
 BUILDING SYSTEMS SPECIALISTS
 P.O. BOX 1421 • WALLINGFORD, CT 06492

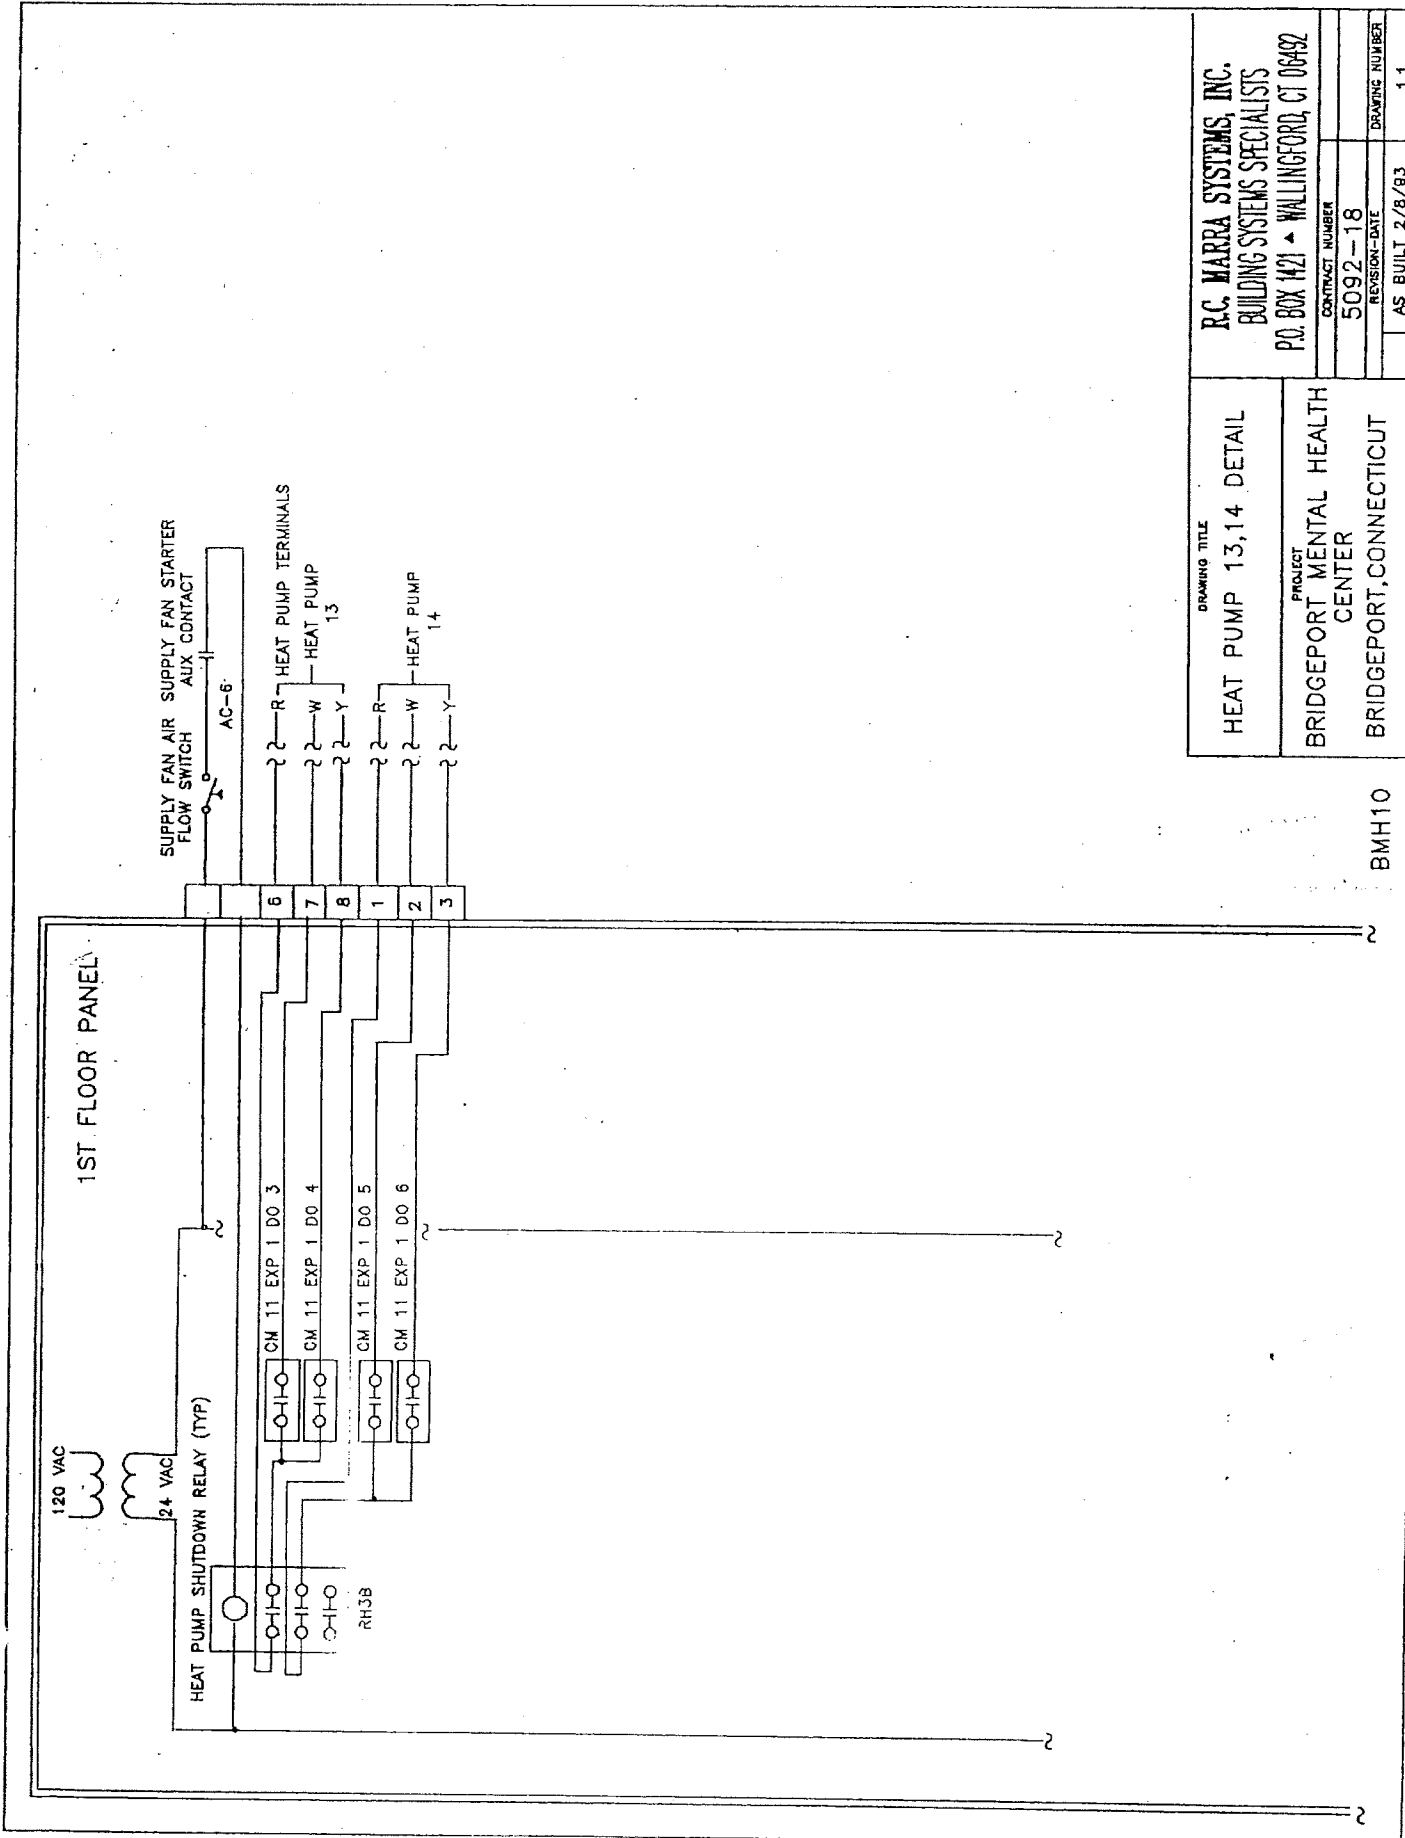

BMH10

DRAWING TITLE	
HEAT PUMP 13,14 DETAIL	
PROJECT	
BRIDGEPORT MENTAL HEALTH CENTER	
BRIDGEPORT, CONNECTICUT	
CONTRACT NUMBER	
5092-18	
REVISION-DATE	
AS BUILT 2/8/83	
DRAWING NUMBER	
11	



R.C. MARRA SYSTEMS, INC.
 BUILDING SYSTEMS SPECIALISTS
 P.O. BOX 1421 • WALLINGFORD, CT 06492

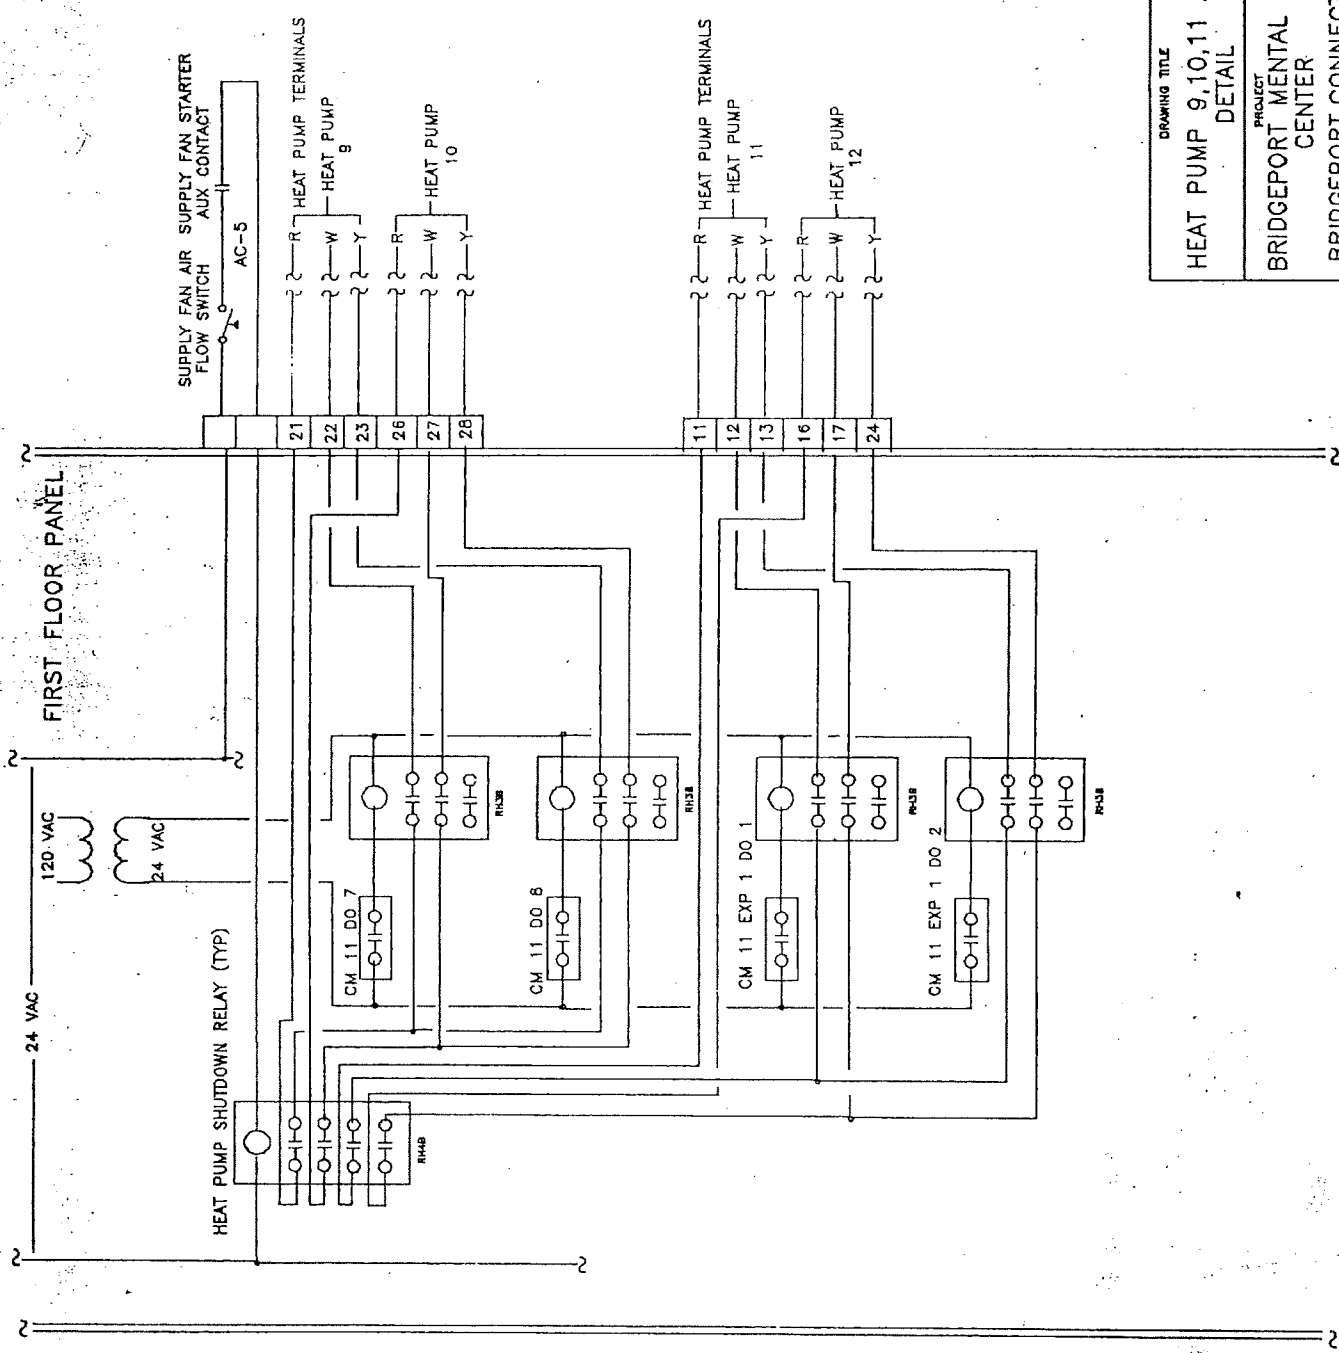

DRAWING TITLE HEAT PUMP 9, 10, 11 AND 12 DETAIL	
PROJECT BRIDGEPORT MENTAL HEALTH CENTER	
LOCATION BRIDGEPORT, CONNECTICUT	
CONTRACT NUMBER 5092-18	REVISION-DATE AS BUILT 2/8/83
DRAWING NUMBER 12	

BMH11



R.C. MARRA SYSTEMS, INC.
 BUILDING SYSTEMS SPECIALISTS
 P.O. BOX 1421 - WALLINGFORD, CT 06492

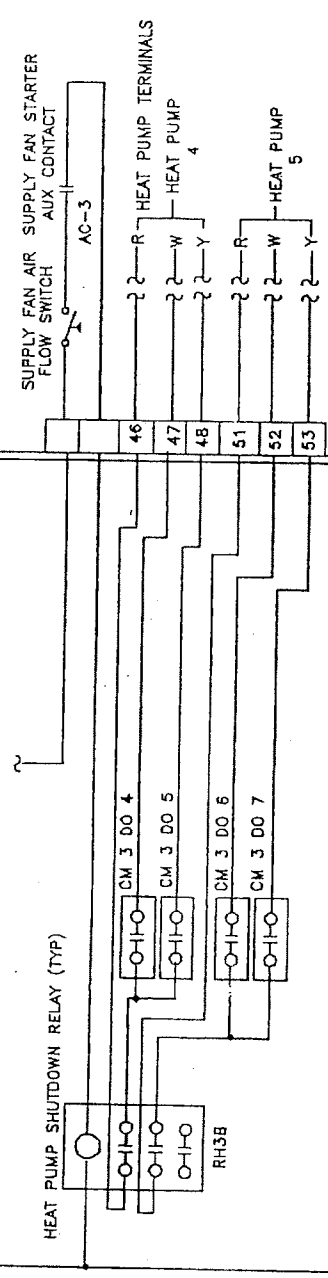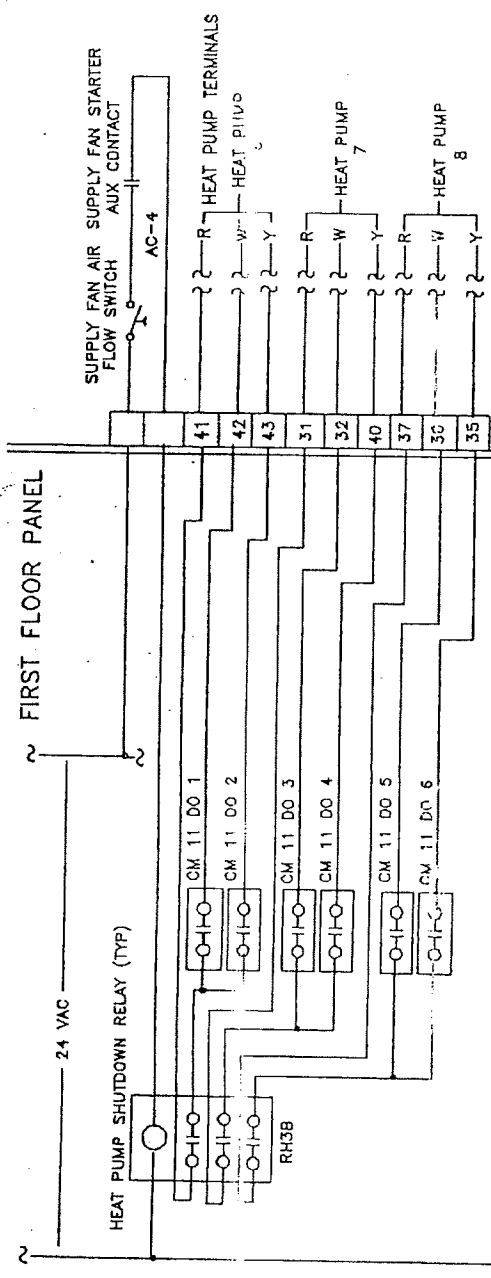


DRAWING TITLE		R.C. MARRA SYSTEMS, INC.	
HEAT PUMP 4,5,6,7 AND 8		BUILDING SYSTEMS SPECIALISTS	
DETAIL		P.O. BOX 1421 - WALLINGFORD, CT 06492	
PROJECT		CONTRACT NUMBER	5092-18
BRIDGEPORT MENTAL HEALTH CENTER		REVISION-DATE	AS BUILT 2/8/83
BRIDGEPORT, CONNECTICUT		DRAWING NUMBER	
BMH12		13	

FIRST FLOOR PANEL

FOR CONTROL MODULE DETAILS
SEE DRAWING 15

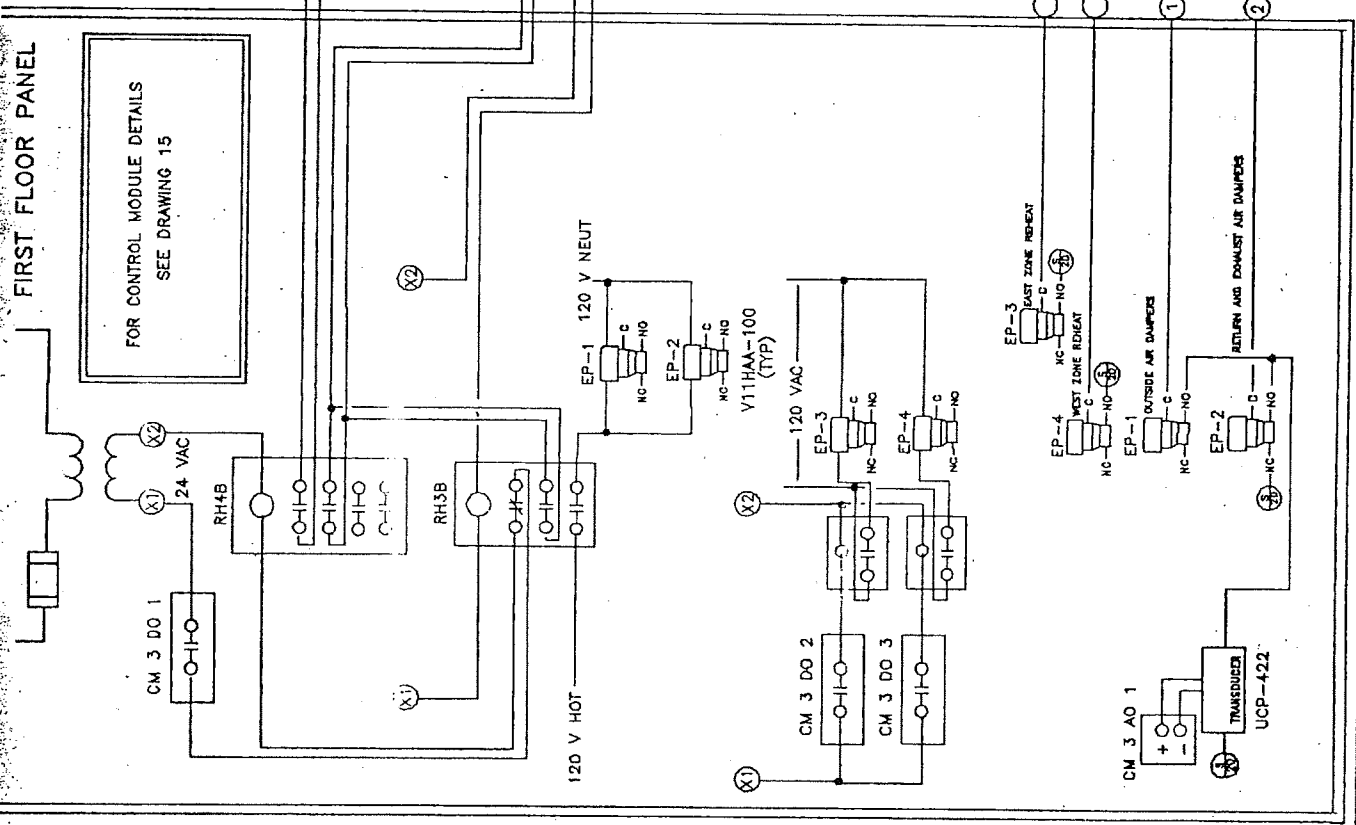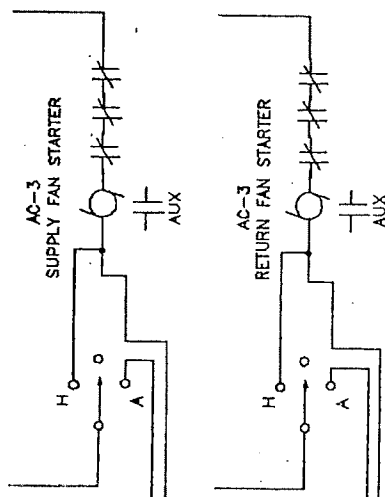




DRAWING TITLE		CONTROL MODULE 3 DETAILS	
PROJECT		BRIDGEPORT MENTAL HEALTH CENTER	
DRAWING NUMBER		BMH13	
CONTRACT NUMBER		R.C. MARRA SYSTEMS, INC. BUILDING SYSTEMS SPECIALISTS P.O. BOX 1421 • WALLINGFORD, CT 06492	
REVISION-DATE		5092-18	
DRAWING NUMBER		AS BUILT 2/8/93	
DRAWING NUMBER		14	

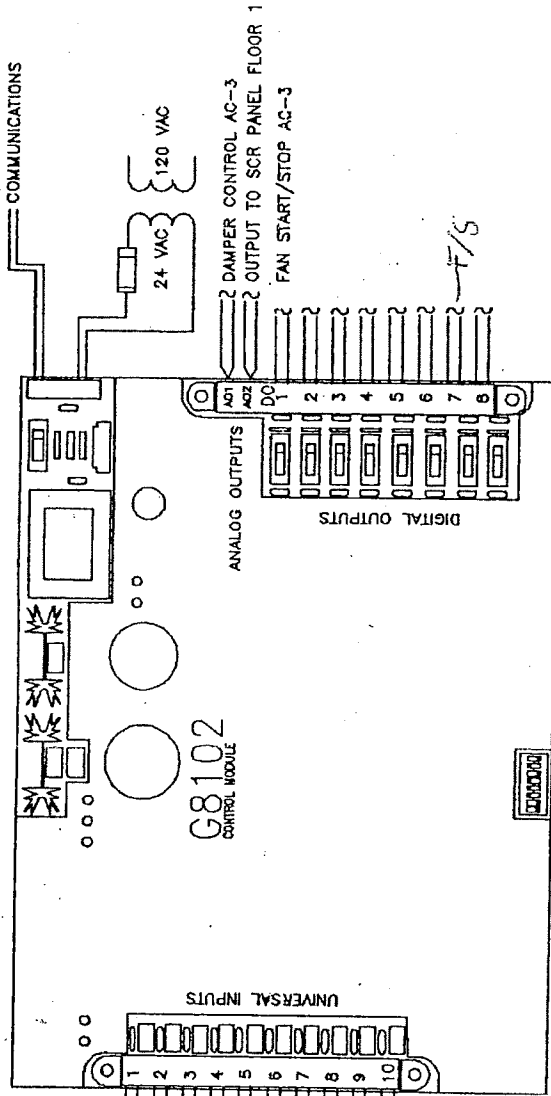



DRAWING TITLE		R.C. MARRA SYSTEMS, INC. BUILDING SYSTEMS SPECIALISTS P.O. BOX 1421 • WALLINGFORD, CT 06492	
CONTROL MODULE 3 DETAILS		CONTRACT NUMBER	5092-18
PROJECT		REVISION DATE	BRIDGE BLDG
BRIDGEPORT MENTAL HEALTH CENTER		AS BUILT	3/8/93
BRIDGEPORT, CONNECTICUT			15

BMH6

COMMUNICATIONS

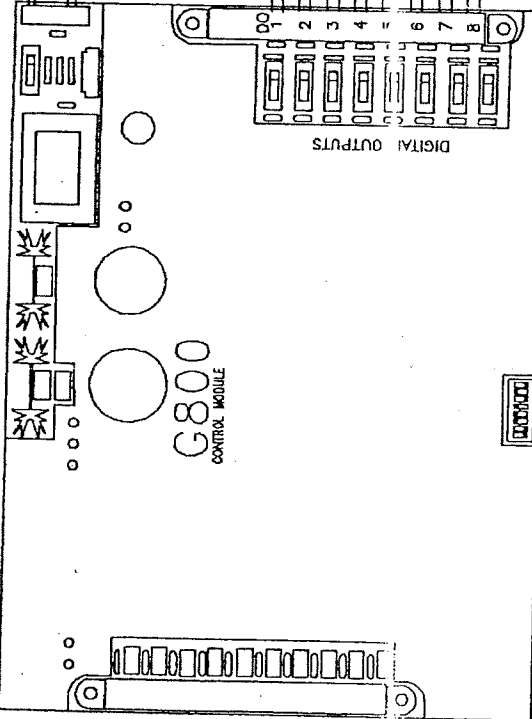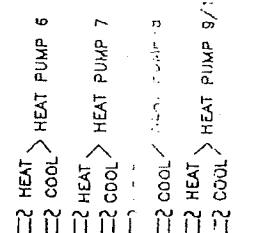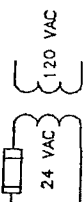

G800
CONTROL MODULE

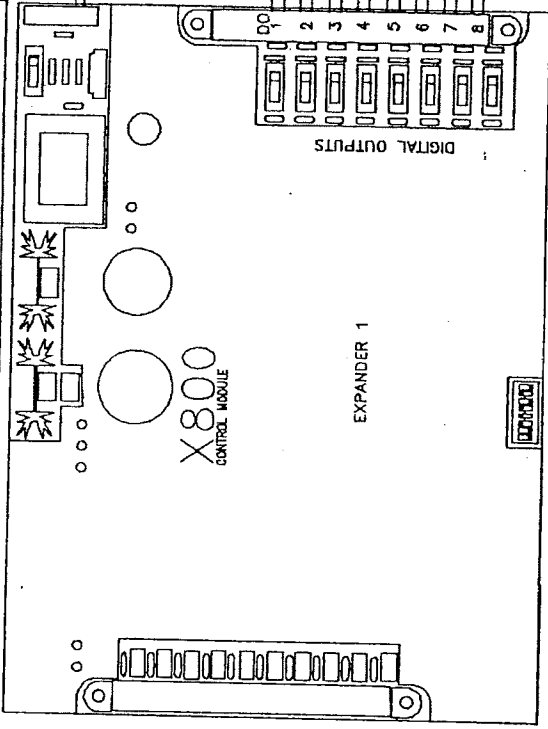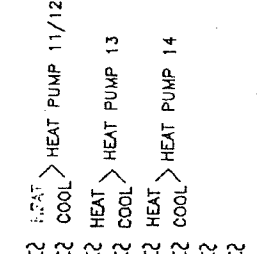

X800
CONTROL MODULE

EXPANDER 1


G8102 DRAWING 15	G800 THIS DRAWING	X800 THIS DRAWING
---------------------	----------------------	----------------------

DRAWING TITLE
CONTROL MODULE 11
DETAIL

PROJECT
BRIDGEPORT MENTAL HEALTH
CENTER
BRIDGEPORT, CONNECTICUT

R.C. MARRA SYSTEMS, INC.
BUILDING SYSTEMS SPECIALISTS
P.O. BOX 1421 • WALLINGFORD, CT 06492

PROJECT NUMBER 5092-18	DRAWING NUMBER 16
REVISION DATE	AS BUILT 3/8/83

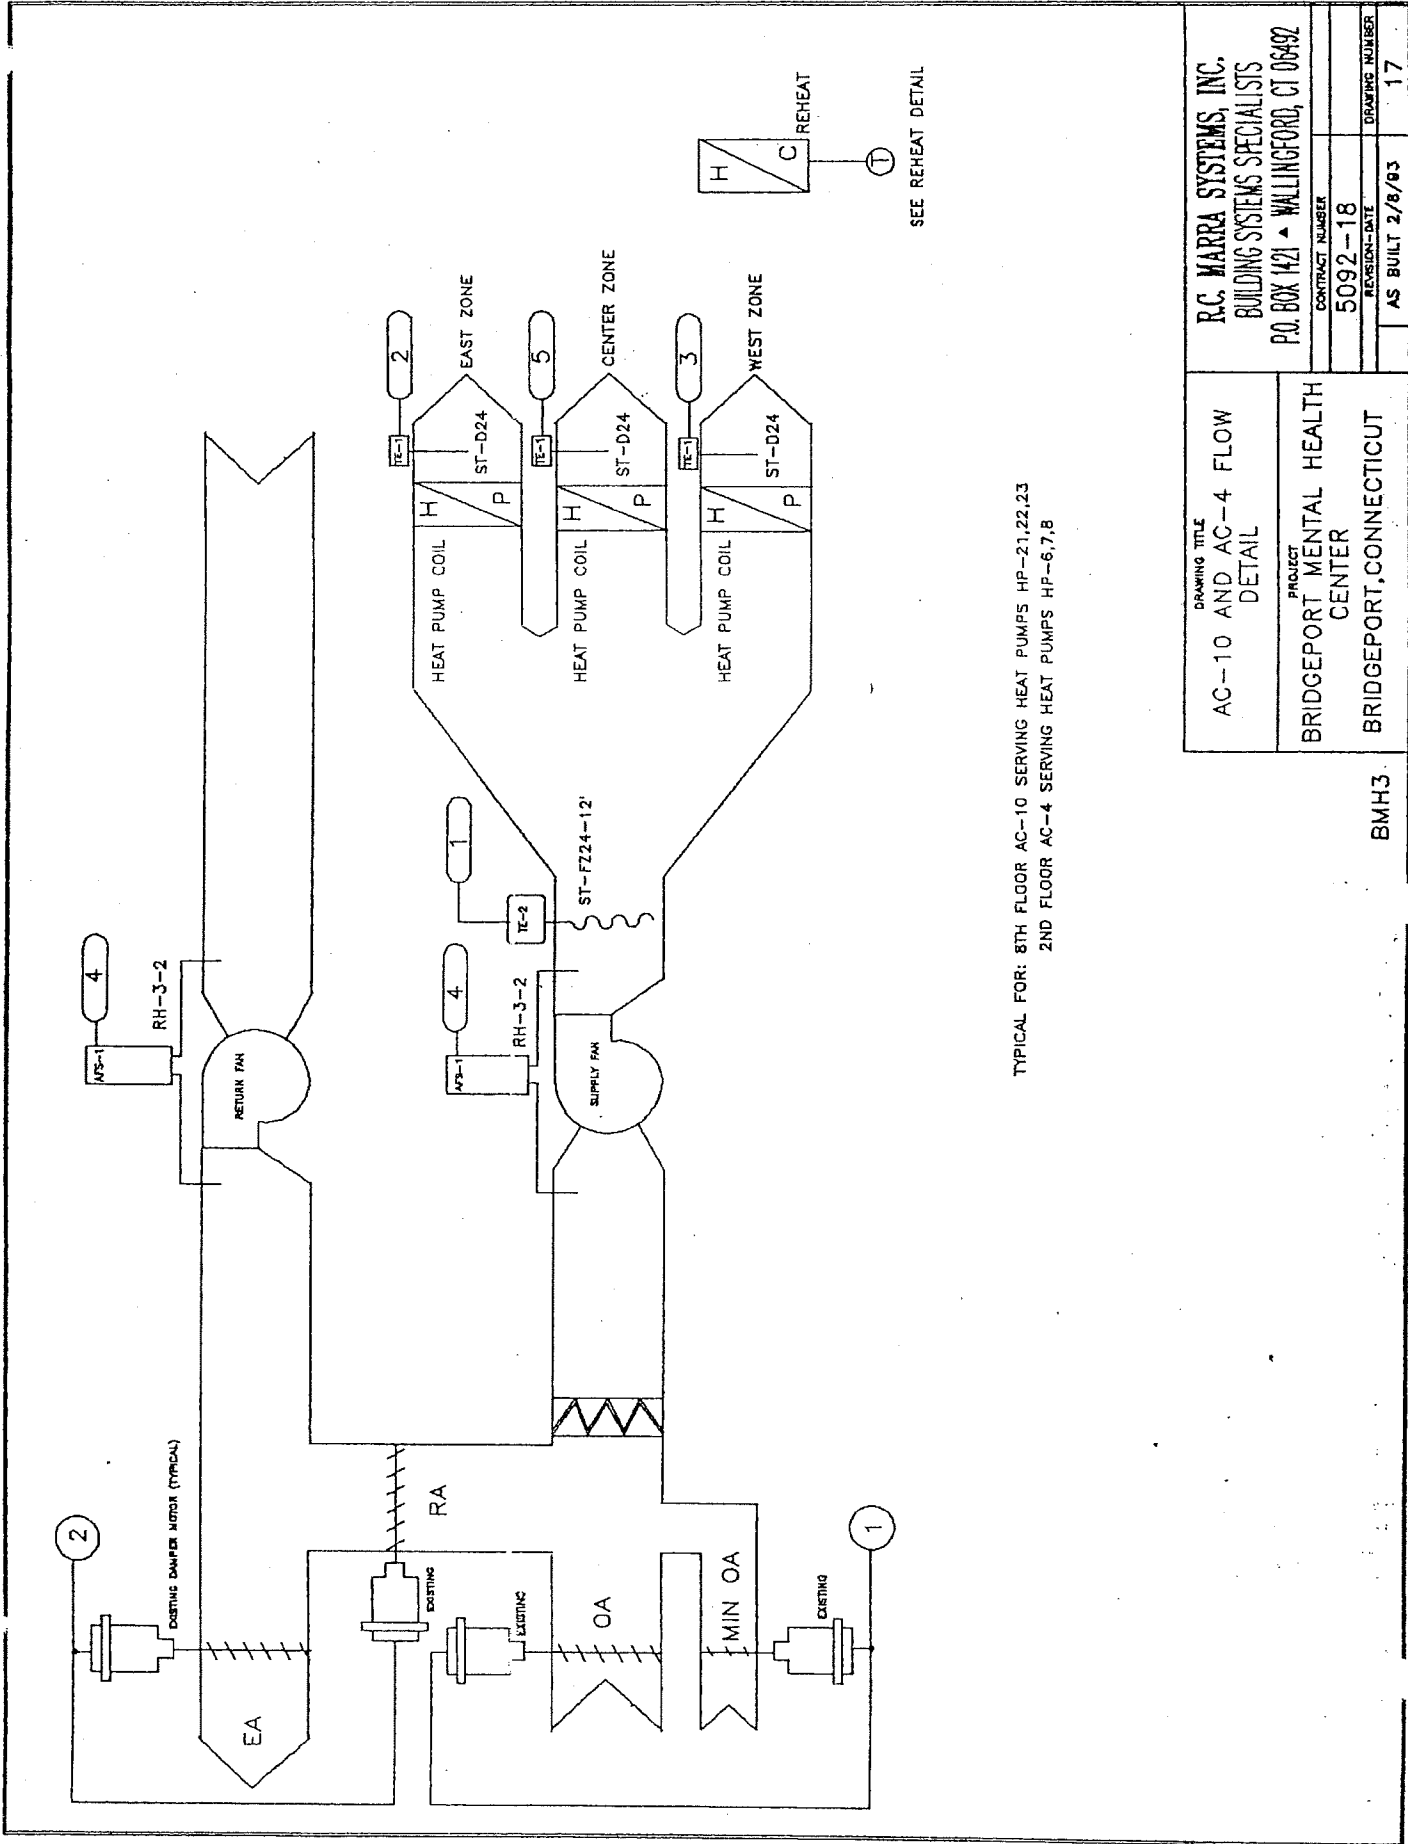

TYPICAL FOR: 8TH FLOOR AC-10 SERVING HEAT PUMPS HP-21,22,23
 2ND FLOOR AC-4 SERVING HEAT PUMPS HP-6,7,8

SEE REHEAT DETAIL

DRAWING TITLE		R.C. MARRA SYSTEMS, INC.	
AC-10 AND AC-4 FLOW DETAIL		BUILDING SYSTEMS SPECIALISTS	
PROJECT		P.O. BOX 1421 • WALLINGFORD, CT 06492	
BRIDGEPORT MENTAL HEALTH CENTER		CONTRACT NUMBER	5092-18
BRIDGEPORT, CONNECTICUT		REVISION-DATE	AS BUILT 2/8/93
BMH3		DRAWING NUMBER	17

R.C. WARRA SYSTEMS, INC.
 BUILDING SYSTEMS SPECIALISTS
 P.O. BOX 1421 • WILMINGTON, CT 06492

CONTRACT NUMBER
 5092-18

REVISION-DATE
 AS BUILT 2/8/83


DRAWING NUMBER
 18

DRAWING TITLE
 HT PUMP 19,20,21,22,23
 CONTROL DETAIL



PROJECT
 BRIDGEPORT MENTAL HEALTH
 CENTER

BRIDGEPORT, CONNECTICUT

BMH5

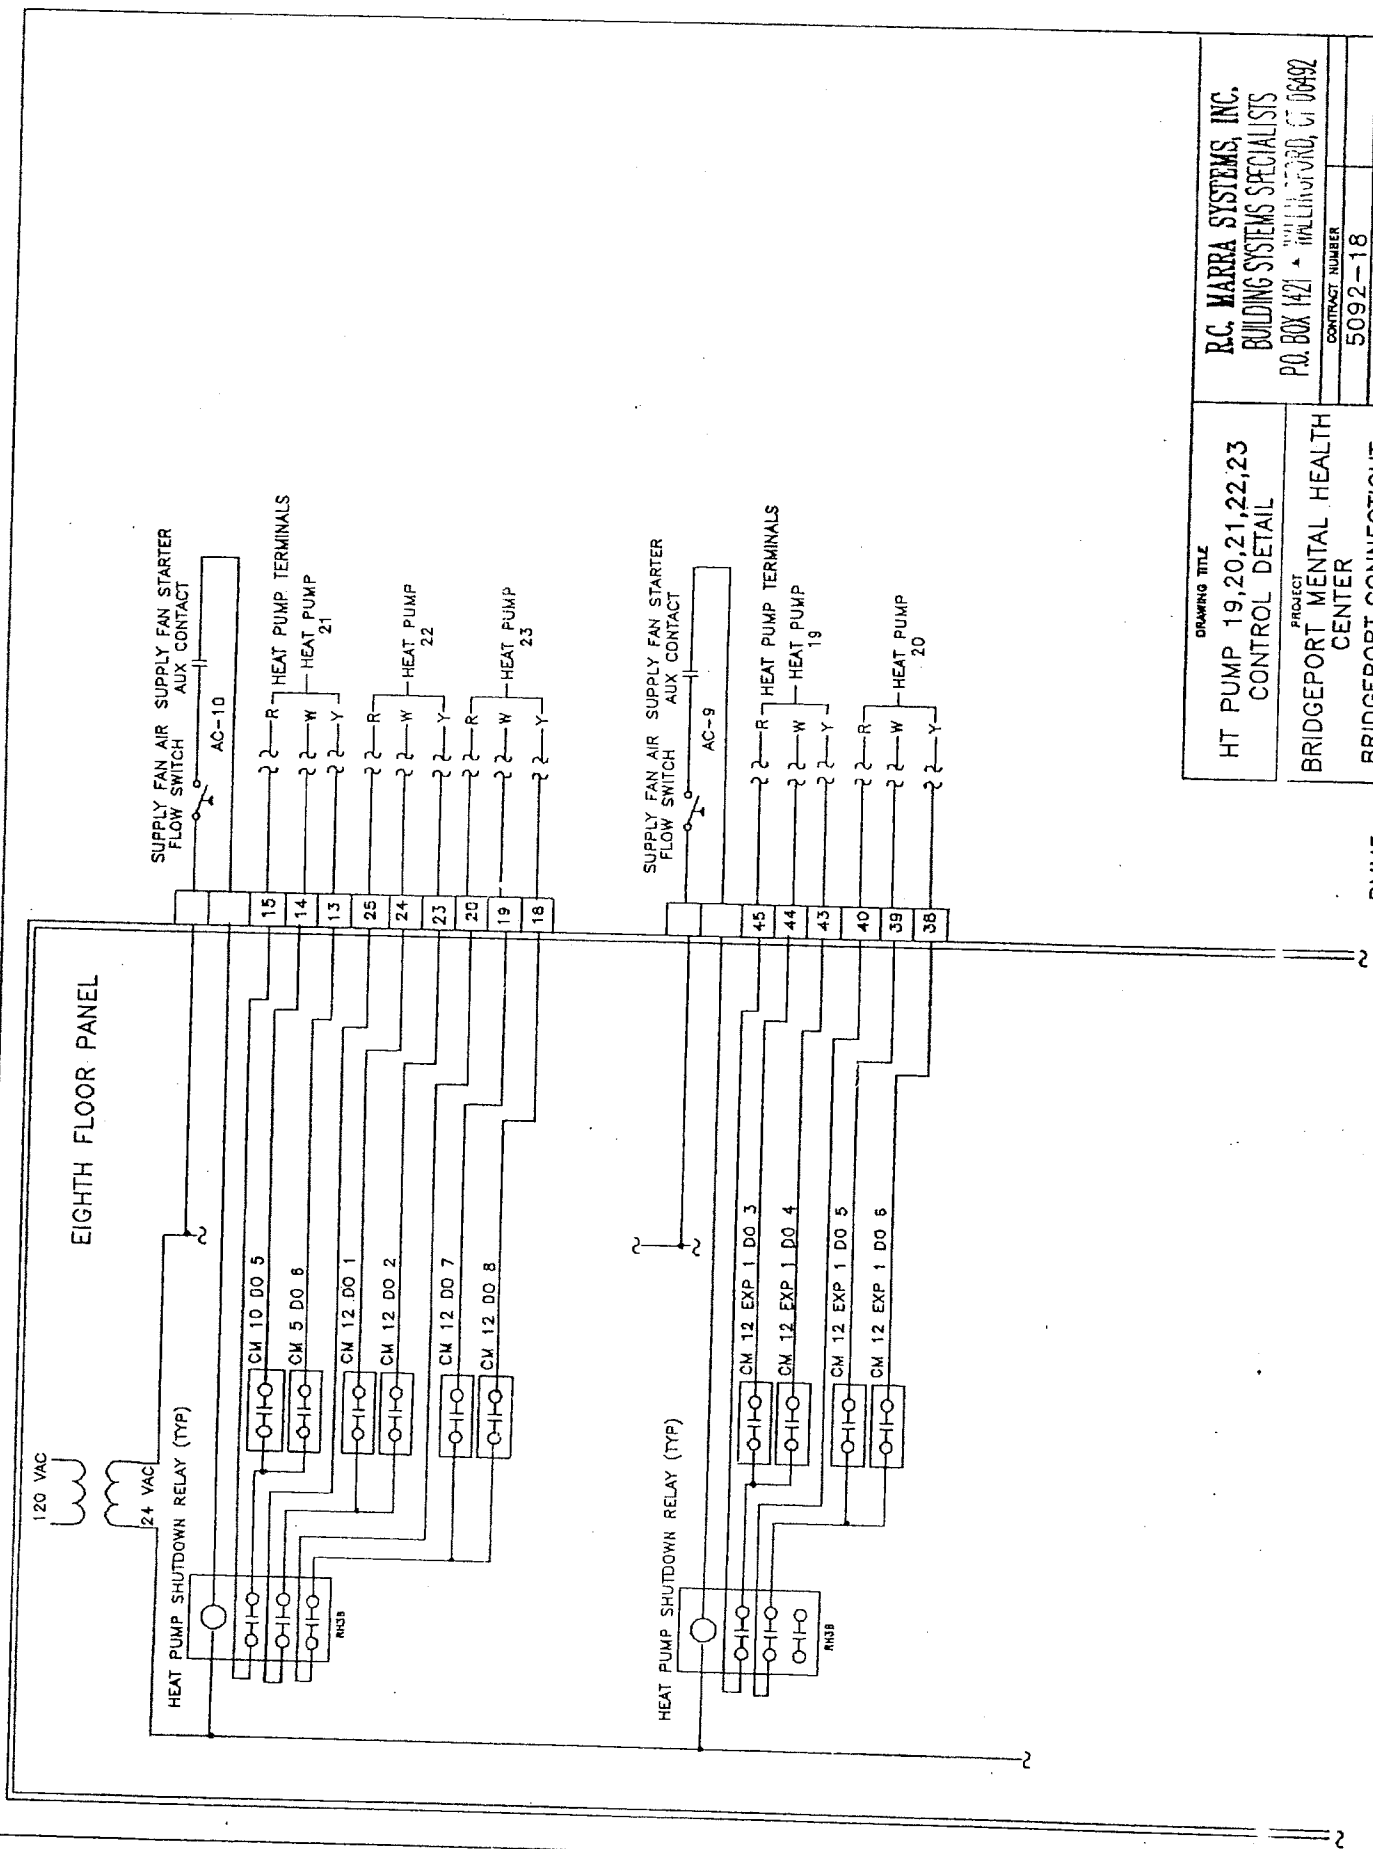


EIGHTH FLOOR PANEL

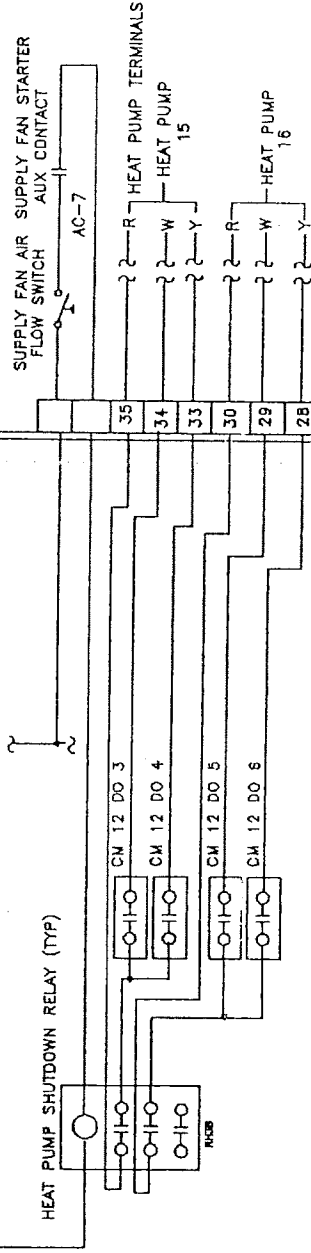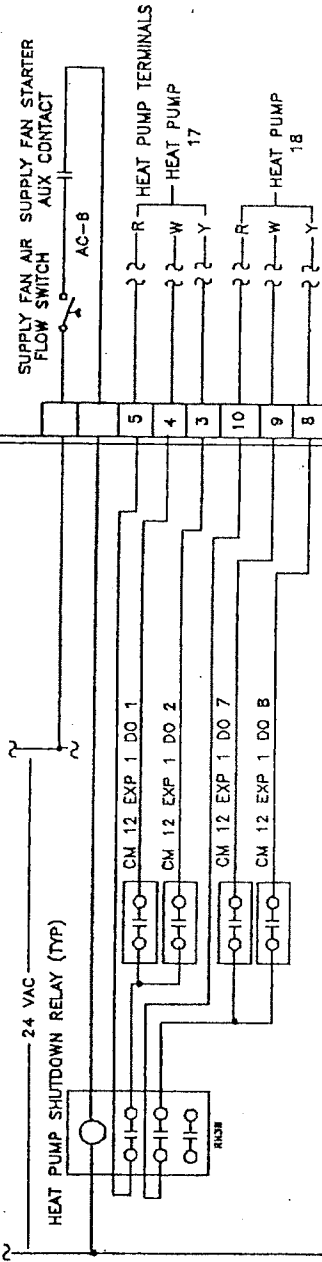

DRAWING TITLE HEAT PUMP 15,16,17,18 CONTROL DETAIL		R.C. MARRA SYSTEMS, INC. BUILDING SYSTEMS SPECIALISTS P.O. BOX 1421 • WALLINGFORD, CT 06492	
PROJECT BRIDGEPORT MENTAL HEALTH CENTER		CONTRACT NUMBER 5092-18	REVISION-DATE AS BUILT 2/8/1
BRIDGEPORT, CONNECTICUT		DRAWING NUMBER	19

BMH7

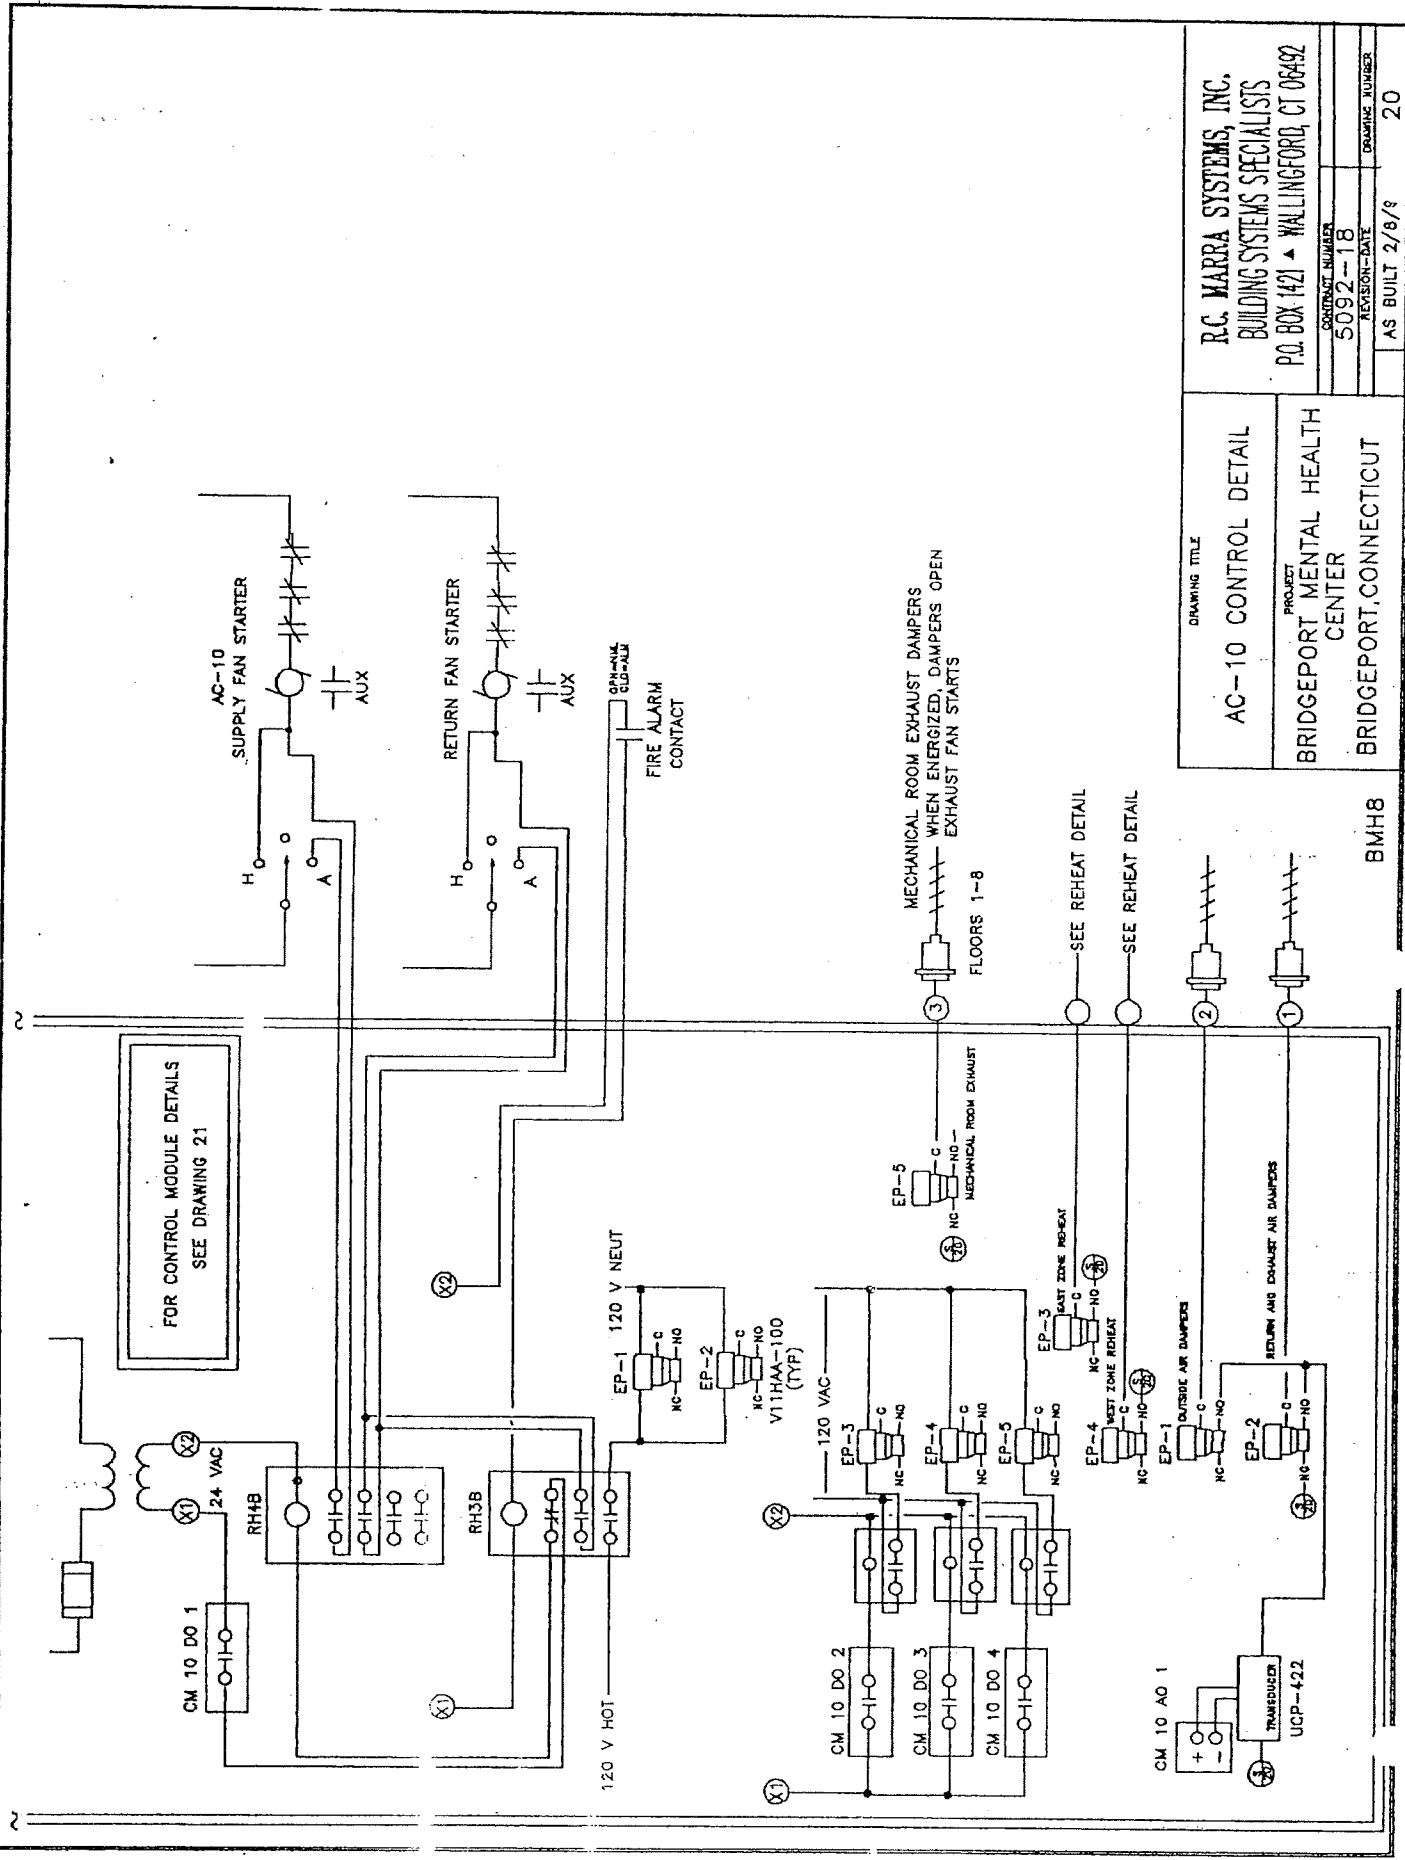


FOR CONTROL MODULE DETAILS
SEE DRAWING 21

DRAWING TITLE		AC-10 CONTROL DETAIL	
PROJECT		BRIDGEPORT MENTAL HEALTH CENTER	
DRAWING NUMBER		BRIDGEPORT, CONNECTICUT	
CONTRACT NUMBER	5092-18	AS BUILT 2/8/8	20
REVISION-DATE			

R.C. MARRA SYSTEMS, INC.
BUILDING SYSTEMS SPECIALISTS
P.O. BOX 1421 • WALLINGFORD, CT 06492

BMH8


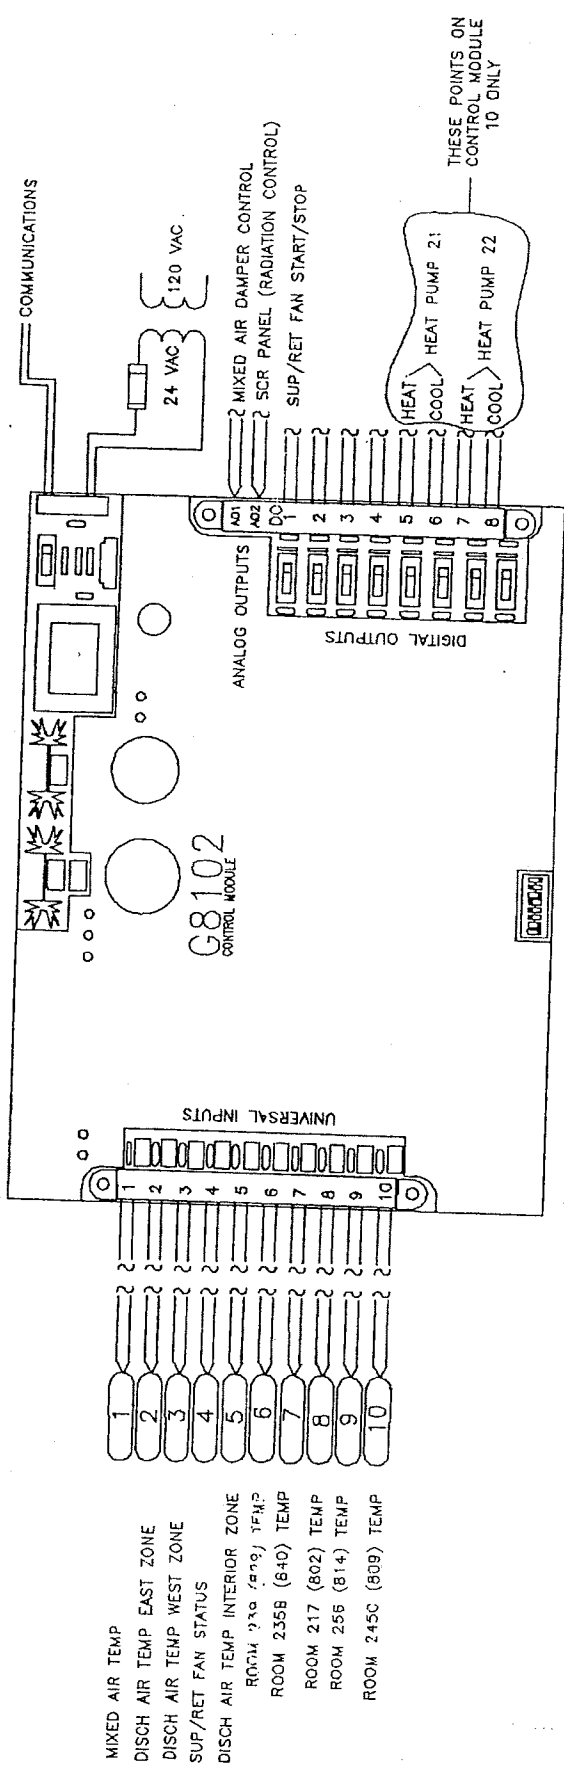


- 1 MIXED AIR TEMP
- 2 DISCH AIR TEMP EAST ZONE
- 3 DISCH AIR TEMP WEST ZONE
- 4 SUP/RET FAN STATUS
- 5 DISCH AIR TEMP INTERIOR ZONE
- 6 ROOM 235B (840) TEMP
- 7 ROOM 217 (802) TEMP
- 8 ROOM 256 (814) TEMP
- 9 ROOM 245C (809) TEMP
- 10



TYPICAL CONTROL MODULE TERMINATION DETAIL FOR: AC-10 CM. 10
AC-4 CM. 4

DRAWING TITLE		R.C. WARRA SYSTEMS, INC. BUILDING SYSTEMS SPECIALISTS P.O. BOX 1421 • WALLINGFORD, CT 06492	
CONTROL MODULE 4, 10		CONTRACT NUMBER	5092-18
DETAILS		REVISION-DATE	AS BUILT 3/6/93
PROJECT		BRIDGEPORT MENTAL HEALTH CENTER BRIDGEPORT, CONNECTICUT	
BMH14		DRAWING NUMBER	21

COMMUNICATIONS

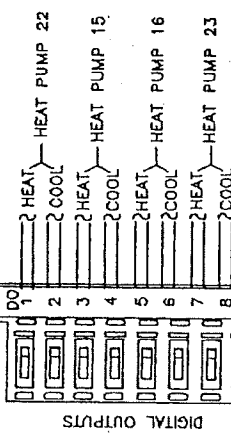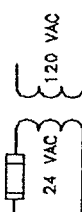

G800
CONTROL MODULE

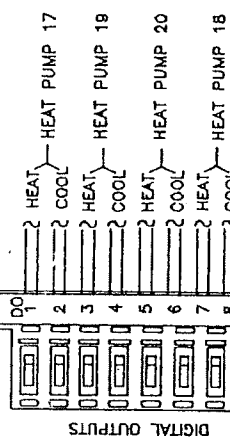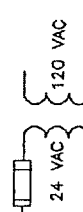

X800
CONTROL MODULE



EXPANDER 1

G8102 DRAWING 21	G800 THIS DRAWING	X800 THIS DRAWING
---------------------	----------------------	----------------------

DRAWING TITLE CONTROL MODULE 12 DETAIL
PROJECT BRIDGEPORT MENTAL HEALTH CENTER BRIDGEPORT, CONNECTICUT

R.C. VARA SYSTEMS, INC. BUILDING SYSTEMS SPECIALISTS P.O. BOX 1421 - WALLINGFORD, CT 06492	
CONTRACT NUMBER 5092-18	REVISION-DATE AS BUILT 3/8/93
DRAWING NUMBER 22	

BMH25

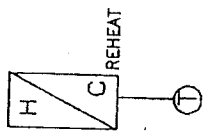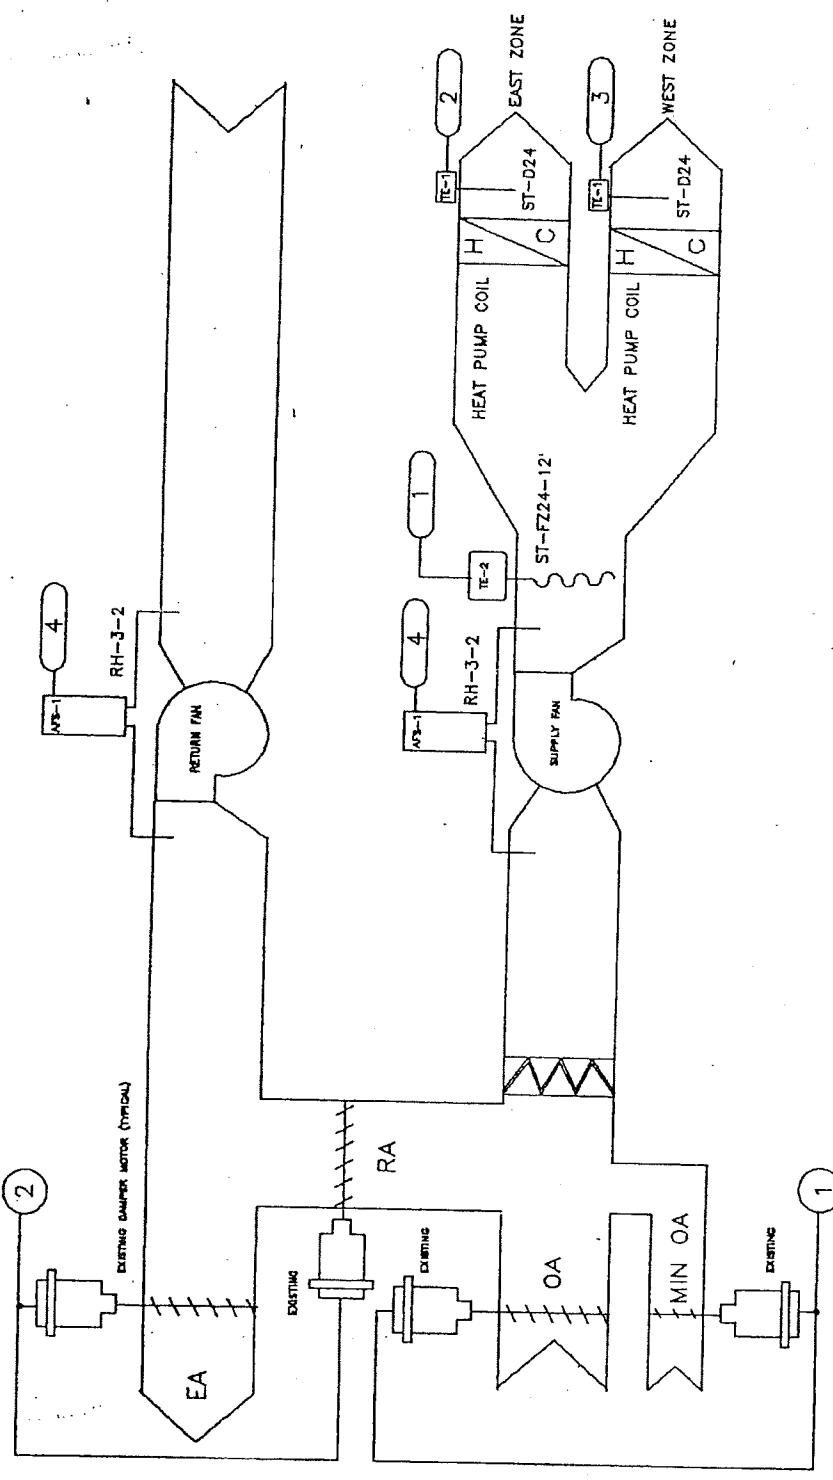


SEE REHEAT DETAIL

- TYPICAL FOR: 7TH FLOOR AC-9 SERVING HEAT PUMPS HP-19,20
 6TH FLOOR AC-8 SERVING HEAT PUMPS HP-17,18
 5TH FLOOR AC-7 SERVING HEAT PUMPS HP-15,16
 4TH FLOOR AC-6 SERVING HEAT PUMPS HP-13,14
 3RD FLOOR AC-5 SERVING HEAT PUMPS 9/10,11/12

DRAWING TITLE		R.C. MARRA SYSTEMS, INC.	
AC-5,6,7,8 AMD 9		BUILDING SYSTEMS SPECIALISTS	
FLOW DETAIL		P.O. BOX 1421 - WALLINGFORD, CT 06492	
PROJECT		CONTRACT NUMBER	5092-18
BRIDGEPORT MENTAL HEALTH CENTER		REVISION-DATE	AS BUILT 2/8/11
BRIDGEPORT, CONNECTICUT		DRAWING NUMBER	23


BMH4

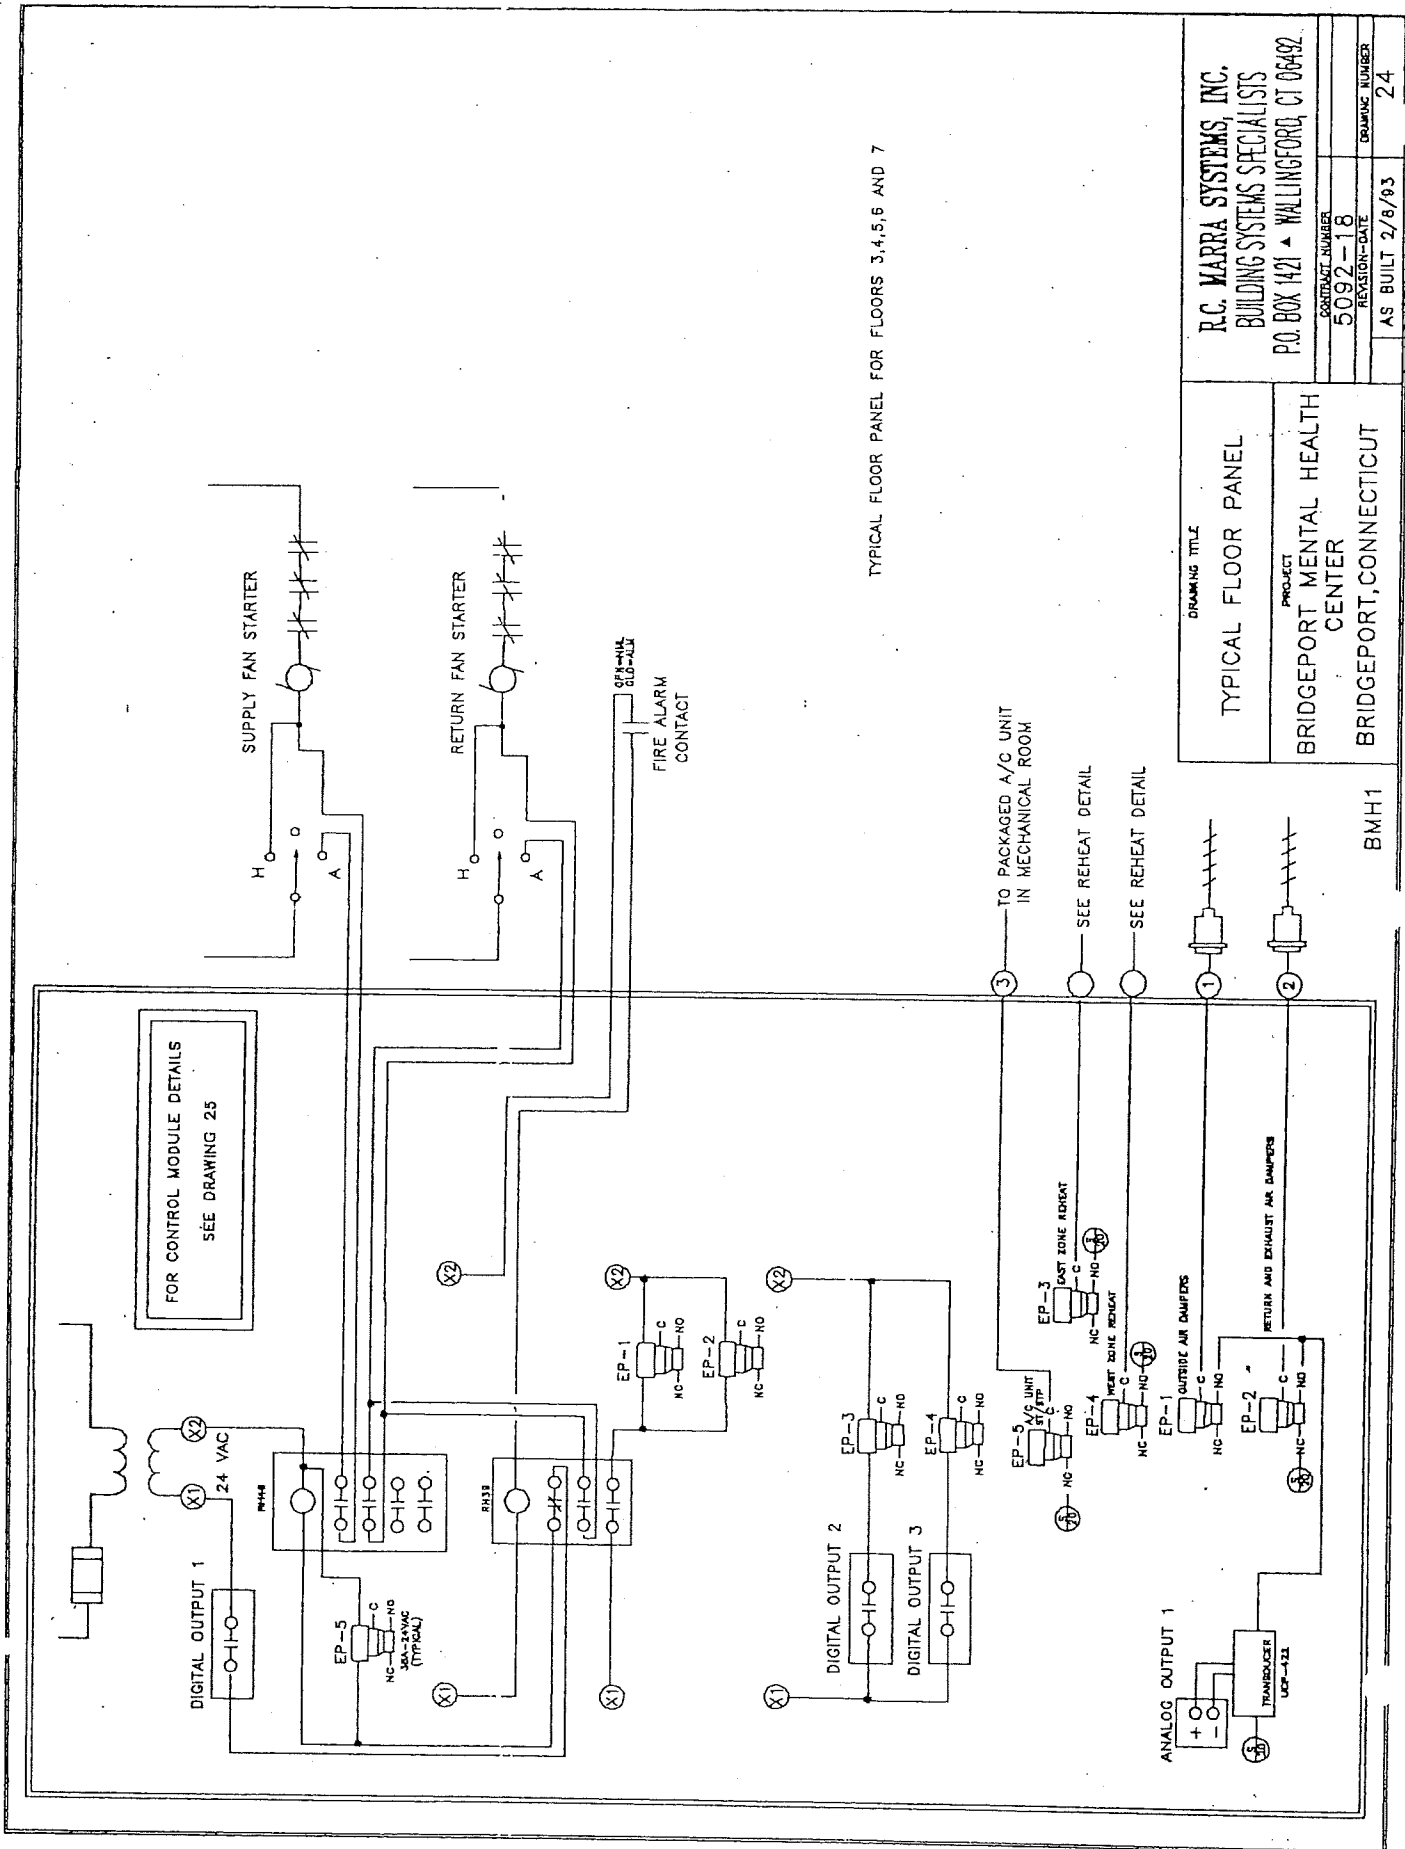


TYPICAL FLOOR PANEL FOR FLOORS 3,4,5,6 AND 7

DRAWING TITLE		R.C. WARRA SYSTEMS, INC.	
TYPICAL FLOOR PANEL		BUILDING SYSTEMS SPECIALISTS	
PROJECT		P.O. BOX 1421 • WALLINGFORD, CT 06492	
BRIDGEPORT MENTAL HEALTH CENTER		CONTRACT NUMBER	5092-18
BRIDGEPORT, CONNECTICUT		REVISION-DATE	
		AS BUILT	2/8/93
		DRAWING NUMBER	24

BMH1


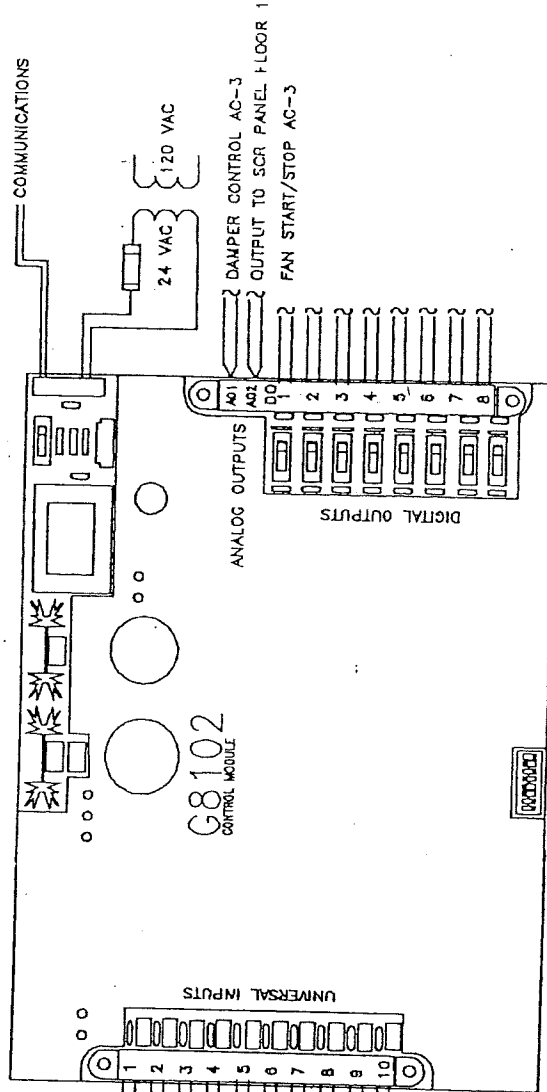


TYPICAL CONTROL MODULE DETAIL FOR FLOORS 3, 4, 5, 6 AND 7

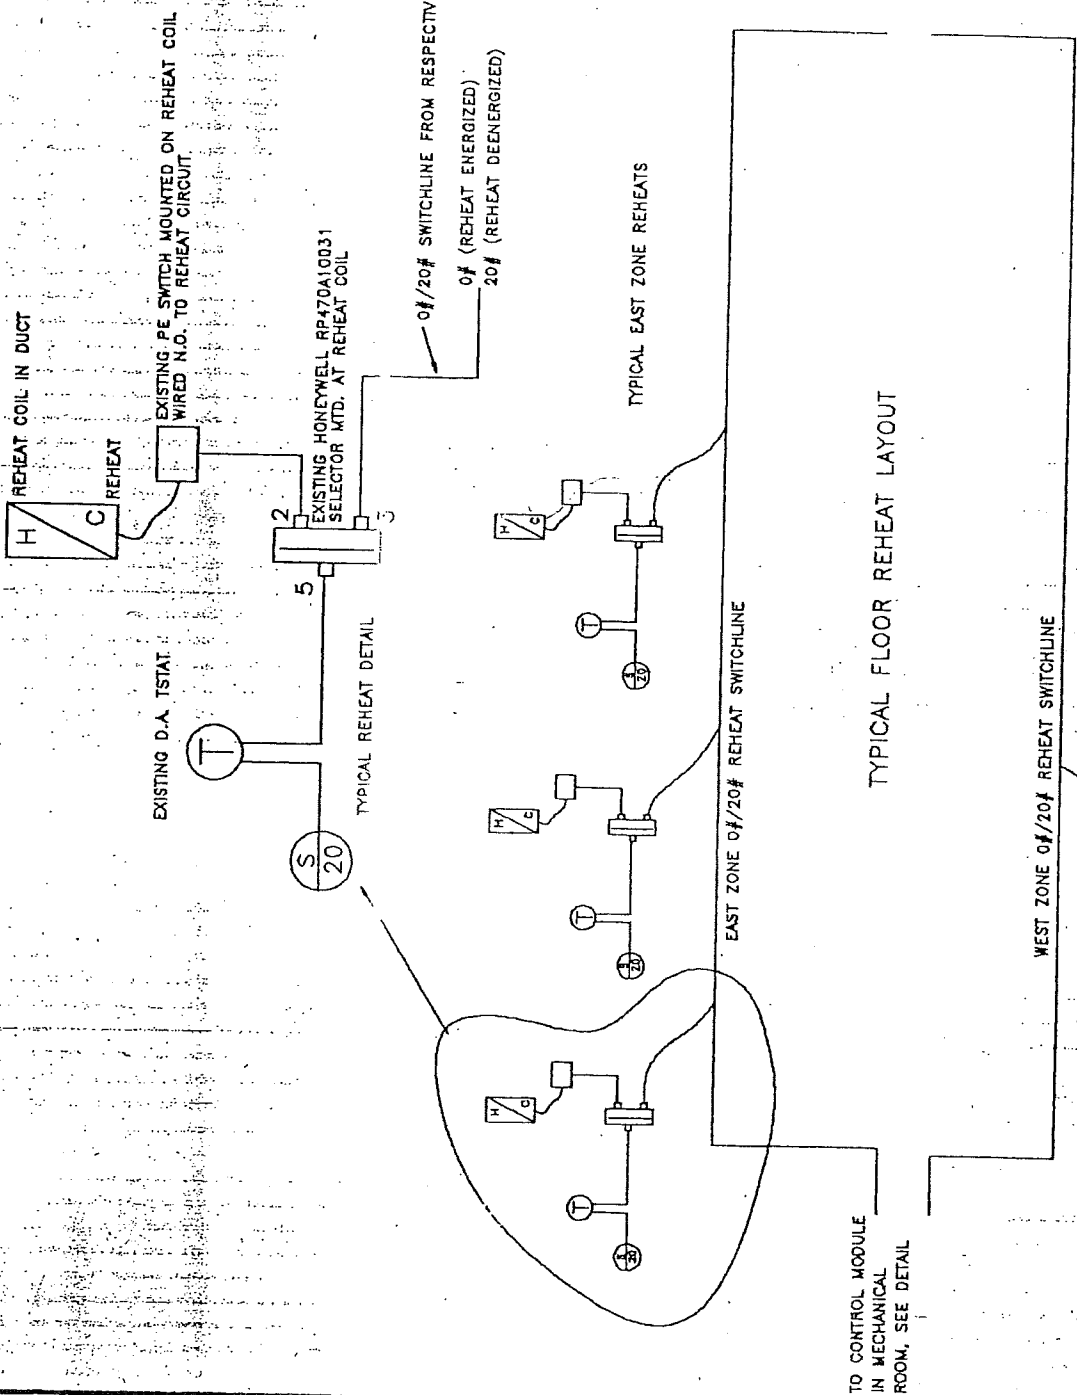

DRAWING TITLE		R.C. VARRA SYSTEMS, INC.	
TYPICAL FLOOR REHEAT DETAIL		BUILDING SYSTEMS SPECIALISTS	
PROJECT		P.O. BOX 1421 - WALLINGFORD, CT 06492	
BRIDGEPORT MENTAL HEALTH CENTER		CONTRACT NUMBER	5092-18
BRIDGEPORT, CONNECTICUT		REVISION-DATE	AS BUILT 2/8/83
BMH9		DRAWING NUMBER	26

BRIDGEPORT HOSPITAL
 MENTAL HEALTH CENTER
 ENERGY MANAGEMENT BY
 R. C. MARRA COMPANY
 WALLINGFORD, CT

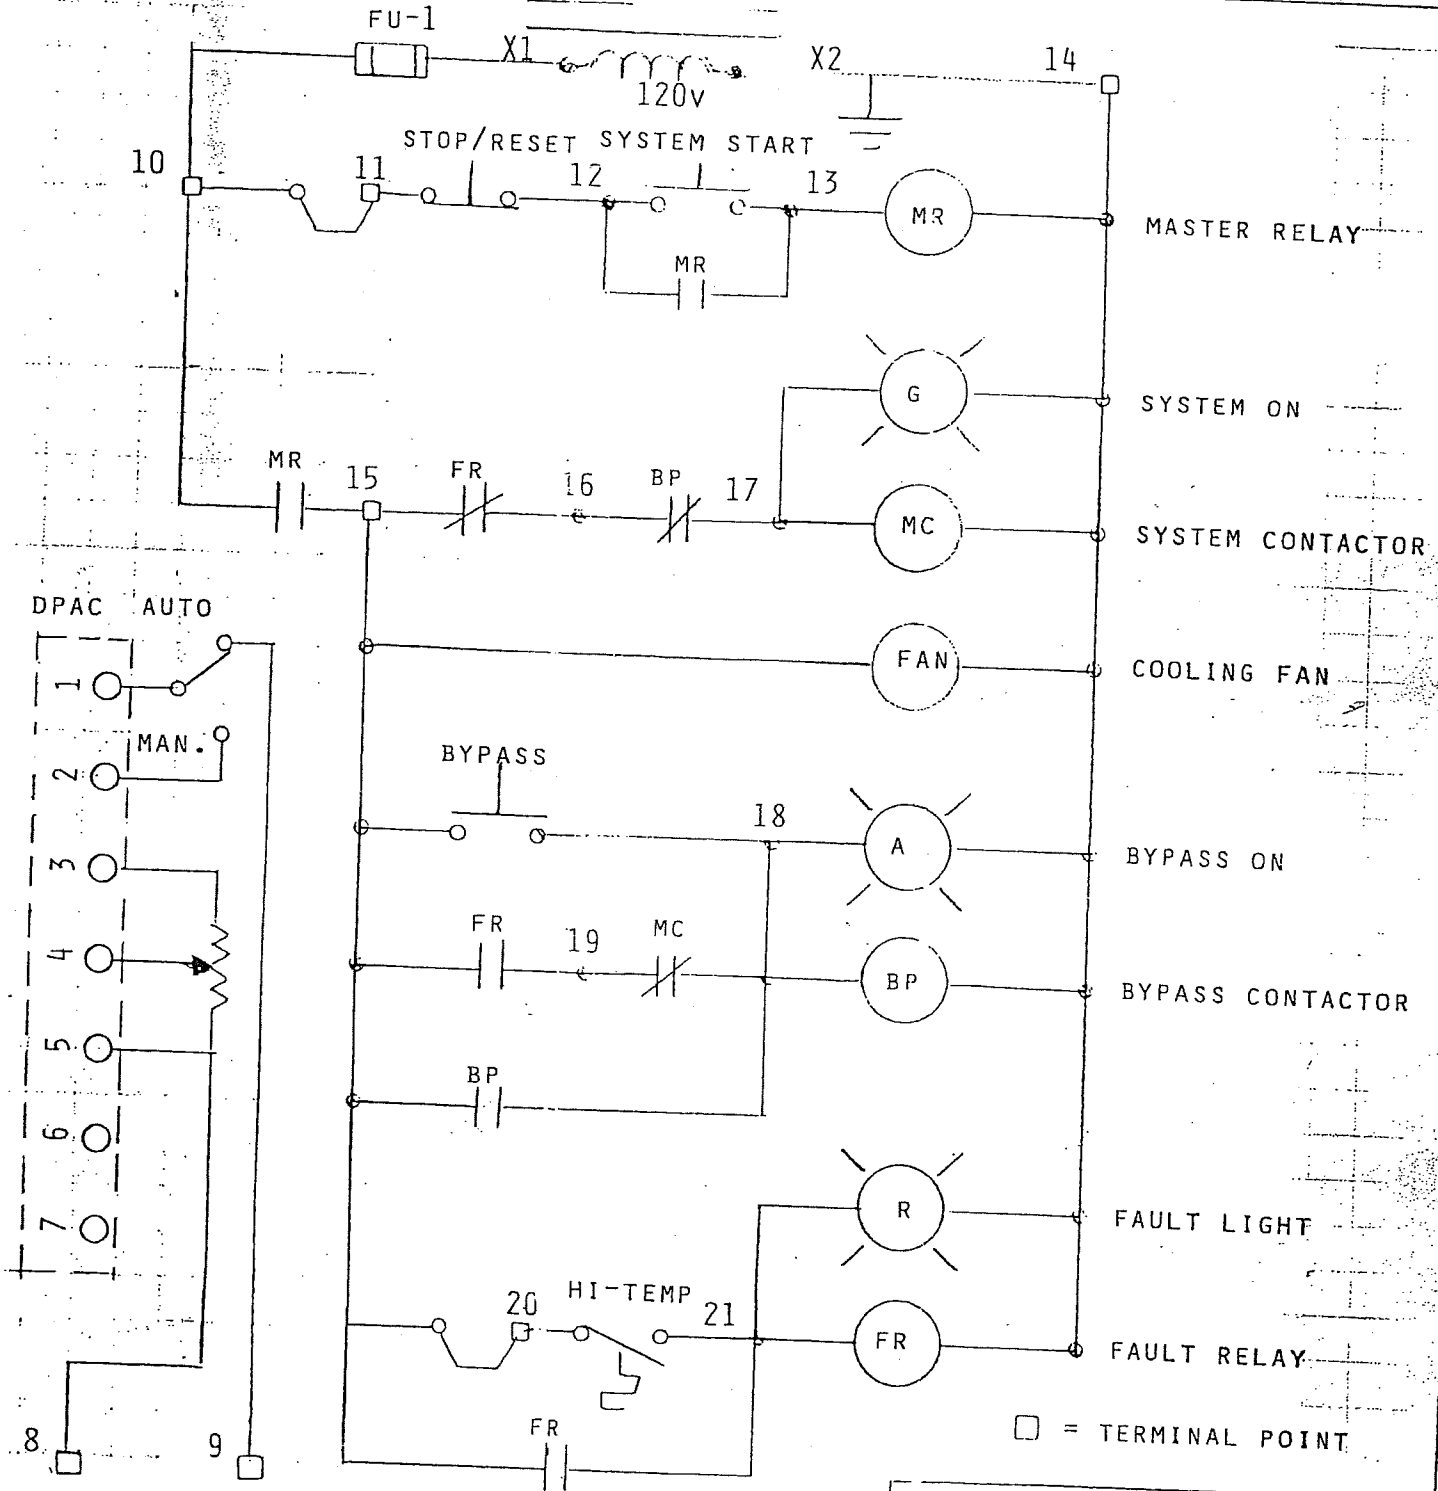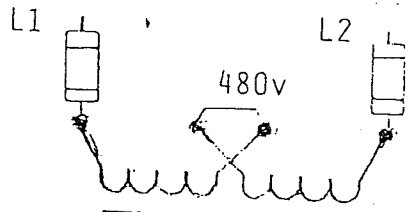

DPAC AUTO

STOP/RESET SYSTEM START

120V

480V

INPUT 0 TO 5VDC

DWN. BY: PAF 11/20/92
 REV.NO.1 12/7/92

THE WHELAN CO.
 211 LEDYARD ST.
 HARTFORD, CT 06114

□ = TERMINAL POINT

DCS Project No.:	BI MH 111	Meeting Purpose:
Date:	November 23, 2015	<input checked="" type="checkbox"/> Pre-Bid Meeting
Meeting Start Time:	1:00 pm	<input type="checkbox"/> Post Bid Review Meeting
Meeting Location:	GBCMHC Cafeteria	<input type="checkbox"/> Other:

Name: Wayne E. Thorpe	Title: Project Manager
Company/Department: DAS/Div. of Construction Services	E-mail: wayne.thorpe@ct.gov
Street: 165 Capitol Ave. Room 460	Phone: 860 713 5618
City/State/Zip Hartford, CT 06106	FAX: 860 713 7261

Name: Jennifer Thurber	Title: Project Engineer
Company/Department: Fuss & O'Neill	E-mail: jthurber@fando.com
Street: 146 Hartford Road	Phone: 860 646 2469 x5538
City/State/Zip Manchester, CT 06040	FAX:

Name: David Jackson	Title: Vice President
Company/Department: Fuss & O'Neill	E-mail: djackson@fando.com
Street: 146 Hartford Road	Phone: 860 646 2469 x 5304
City/State/Zip Manchester, CT 06040	FAX:

Name: Steve Hecimovich	Title: Director of Engineering Services
Company/Department: Dept. of Mental Health & Addiction Services	E-mail: steven.hecimovich@ct.gov
Street: Holmes Drive P.O. Box 351	Phone: 860 262 5301
City/State/Zip Middletown, CT 06457	FAX: 860 262 5307

Name: <i>Pete Cappellino</i>	Title: <i>Estimator</i>
Company/Department: <i>JA Rosa Construction</i>	E-mail: <i>pete@jarosa.com</i>
Street: <i>17 Town Line Rd</i>	Phone: <i>203-879-3495</i>
City/State/Zip: <i>Wolcott CT 06716</i>	FAX: <i>203-879-0760</i>

Name: <i>Gabe Agnello</i>	Title: <i>PM - Estimator</i>
Company/Department: <i>Sarracco Mech</i>	E-mail: <i>G.Agnello@Sarracco.com</i>
Street: <i>25 Elizabeth Street</i>	Phone: <i>203-565-3933</i>
City/State/Zip: <i>Norwalk CT 0</i>	FAX:



Division of
Construction Services

6020
Bid Phase Meeting
Attendance Log

DCS Project No.:	BI MH 111	Meeting Purpose:
Date:	November 23, 2015	<input checked="" type="checkbox"/> Pre-Bid Meeting
Meeting Start Time:	1:00 pm	<input type="checkbox"/> Post Bid Review Meeting
Meeting Location:	GBCMHC Cafeteria	<input type="checkbox"/> Other:

Name:	Frank Mastriano	Title:	Assistant Project Manager
Company/Department:	Holzner Construction	E-mail:	estimating@holznerelectric.com
Street:	596 John St.,	Phone:	203-335-4204
City/State/Zip	Bridgewater, CT 06604	FAX:	203-368-3425

Name:	JAMES A. Kenney Jr	Title:	President.
Company/Department:	Diversity Construction Group	E-mail:	estimating@diversitycg.com
Street:	531 Cortland Circle	Phone:	203-699-8387
City/State/Zip	Cheshire CT 06410	FAX:	203-439-0812

Name:	John Abbate	Title:	Construction Manager
Company/Department:	FPT	E-mail:	john@fireprotectiontesting.com
Street:	1401 Highland Ave	Phone:	860-578-0382
City/State/Zip	Cheshire	FAX:	

Name:	SCOTT STEWART	Title:	EST
Company/Department:	STEWART MECHANICAL	E-mail:	sstewart@stewartmsi.com
Street:	1495 THOMASTON AVE	Phone:	203-575-0440
City/State/Zip	WATERBURY, CT 06704	FAX:	203-575-0424

Name:	JIM BONA	Title:	CM
Company/Department:	ELECTRICAL CONTRACTORS, INC.	E-mail:	JIMB@ECINCORPORATED.COM
Street:	3510 MAIN ST.	Phone:	860-549-2822
City/State/Zip	HARTFORD CT.	FAX:	860-549-7948

Name:		Title:	
Company/Department:		E-mail:	
Street:		Phone:	
City/State/Zip		FAX:	



Division of Construction Services

6020 Bid Phase Meeting Attendance Log

DCS Project No.:	BI MH 111	Meeting Purpose:
Date:	November 23, 2015	<input checked="" type="checkbox"/> Pre-Bid Meeting
Meeting Start Time:	1:00 pm	<input type="checkbox"/> Post Bid Review Meeting
Meeting Location:	GBCMHC Cafeteria	<input type="checkbox"/> Other:

Name:	Donald J. Johnson	Title:	Senior Sales Engineer
Company/Department:	Sarracco Mechanical Service	E-mail:	DJohnson@Sarracco.com
Street:	71 Naugatuck Est. Drive	Phone:	203-410-6168
City/State/Zip	Naugatuck Ct 06770	FAX:	

Name:		Title:	
Company/Department:		E-mail:	
Street:		Phone:	
City/State/Zip		FAX:	

Name:		Title:	
Company/Department:		E-mail:	
Street:		Phone:	
City/State/Zip		FAX:	

DCS Project No.:	BI MH 111	Meeting Purpose:
Date:	November 23, 2015	<input checked="" type="checkbox"/> Pre-Bid Meeting
Meeting Start Time:	1:00 pm	<input type="checkbox"/> Post Bid Review Meeting
Meeting Location:	GBCMHC Cafeteria	<input type="checkbox"/> Other:

Name:	CASEY DALY	Title:
Company/Department:	Tomlinson Hawley Patterson	E-mail:
Street:	2005 Reservoir Ave	Phone:
City/State/Zip	Trumbull CT 06611	FAX:
		203-218-6318

Name:	Vinnie Zavarillo	Title:
Company/Department:	Caruso Electric	E-mail:
Street:	815 Farmington Ave	Phone:
City/State/Zip	New Britain CT 06053	FAX:
		860-832-9469
		Vinnie@CarusoElectric.com

Name:	JOHN GENNARINI	Title:
Company/Department:	GENNARINI CONST CO INC	E-mail:
Street:	25 MAPLE ST.	Phone:
City/State/Zip	Bpt, Ct	FAX:
		GENNARINI.CONST.CO@AOL.COM

Name:	Steve Hecimovich	Title:
Company/Department:	DMHAS	E-mail:
Street:	P.O. Box 351	Phone:
City/State/Zip	Middletown, CT 06457	FAX:
		860-262-5301
		11 5307
		Chief of Engineering
		steven.hecimovich@ct.gov

Name:	JEFF Scinto	Title:
Company/Department:	Southport Contracting Inc.	E-mail:
Street:	1730 Commerce Drive	Phone:
City/State/Zip	Bpt Ct 06605	FAX:
		203-334-2323
		203 334 2321
		Southportcontracting@gmail.com

Name:	John Scinto	Title:
Company/Department:	Southport Contracting Inc	E-mail:
Street:	1730 Commerce Dr	Phone:
City/State/Zip	Bridgeport, Ct 06605	FAX:
		203-334-2323
		203-334-2321
		Southportcontracting@gmail.com

DCS Project No.:	BI MH 111	Meeting Purpose:
Date:	November 23, 2015	<input checked="" type="checkbox"/> Pre-Bid Meeting
Meeting Start Time:	1:00 pm	<input type="checkbox"/> Post Bid Review Meeting
Meeting Location:	GBCMHC Cafeteria	<input type="checkbox"/> Other:

Name:	STEVEN GREENING	Title:	PROJECT MANAGER
Company/Department:	WEST STATE MECHANICAL	E-mail:	WSM-STEVE@YAHOO.COM
Street:	PO BOX 1045	Phone:	800-482-5919
City/State/Zip	TORRINGTON, CT 06790	FAX:	860-489-4686

Name:	DAVE CAMPBELL	Title:	SALES
Company/Department:	AUTOMATED BUILDING SYSTEMS, INC.	E-mail:	dcampbell@absdlc.com
Street:	126 KREIGER LN	Phone:	(860) 982 1708
City/State/Zip	GLASTONBURY CT 06033	FAX:	(860) 657-3135

Name:	Rob Croston	Title:	Service Mgr
Company/Department:	CTC Building Solutions	E-mail:	rcroston@cttempcontrols.com
Street:	500 Corporate Drive	Phone:	(860) 578-5033
City/State/Zip	Cranwell, CT 06416	FAX:	(860) 316-5348

Name:	Jennifer	Title:	
Company/Department:		E-mail:	
Street:		Phone:	
City/State/Zip		FAX:	

Name:	JIM PIND JR.	Title:	PRESIDENT
Company/Department:	OLYMPUS CONSTRUCTION	E-mail:	OLYMPUSJIM@AOL.COM
Street:	77 CHERRY STREET	Phone:	203-878 1544
City/State/Zip	MILFORD CT 06460	FAX:	203 878 6430

Name:	Troy Karwowski	Title:	President
Company/Department:	SAV-MOR Cooling + Heating	E-mail:	troy@savmorct.com
Street:	231 Captain Lewis Dr.	Phone:	860-621-9959
City/State/Zip	Southington, CT 06489	FAX:	860-621-9919